981

Township No. 29 South Range No. 7 West of the Willamette Meridian Oregon.

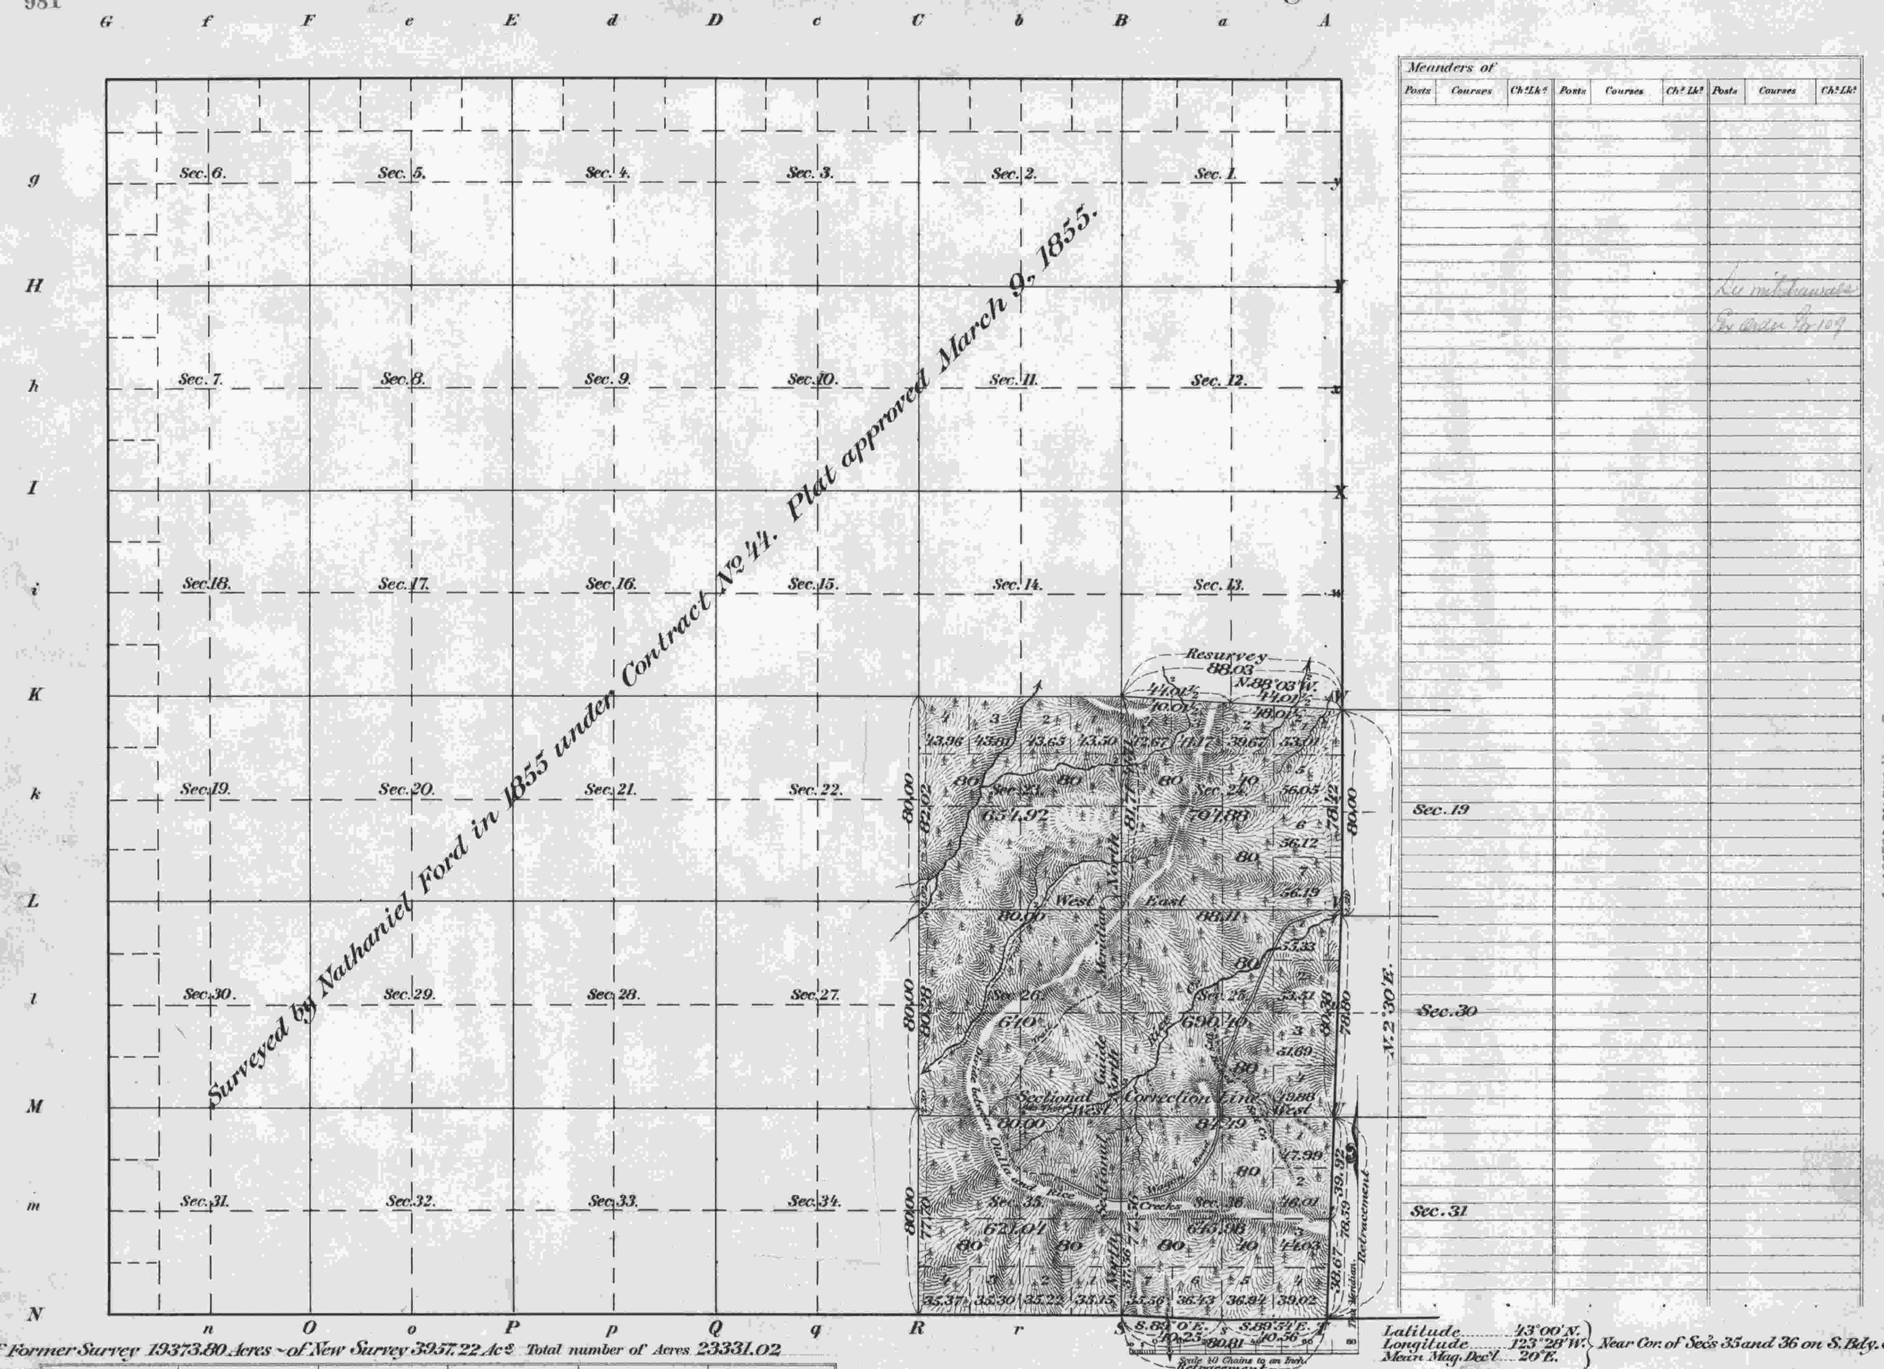

Meanders of

Posts	Courses	Ch.s Lk.s	Posts	Courses	Ch.s Lk.s	Posts	Courses	Ch.s Lk.s

Ex. mil. Traverse
Ex. Order No. 109

ACCEPTED BY THE HON. COMMISSIONER G. L. O.
SEP 26 1911

Latitude 43°00'N.
Longitude 123°28'W.
Mean Mag. Decl. 20°E.
} Near Cor. of Secs. 35 and 36 on S. Bdy. of Tp.

Area of Former Survey 19373.80 Acres ~ of New Survey 3957.22 Acs. Total number of Acres 23331.02

J.W.T.	Surveys Designated	By Whom Surveyed	Date of Contract	Amount of Surveys M.	Ch.s	Lk.s	When Surveyed	No. of Contract
	Subdivisions	Roy T. Campbell.	August 21, 1909.	7	11	87	June 28 to July 6, 1910.	789
	Connections.	" " "	" " "		5	90	" " " " " "	"
	Resurvey of Subdivis.ns	" " "	" " "	1	08	03	" " " " " "	"
	Retracement of South & East Bdy. of Sec. 36	" " "	" " "	1	79	40	" " " " " "	"
	Resurvey of South Bdy. of Secs. 35 and 36.	Wm. H. Byars.	June 3, 1871.				1873	152
	North, South, East & West Bdries. of Tp.	Nathaniel Ford.	May 30, 1854.				1854	44

The above Map of Township No. 29 South of Range No. 7 West of the Willamette Meridian, Oregon is strictly conformable to the field notes of the survey thereof on file in this Office, which have been examined and approved.

Surveyor Generals Office,
Portland, Oregon April 5, 1911.

Sur. Gen.l for Oregon.