ORIGINAL

TOWNSHIP 29 SOUTH, RANGE 7 WEST, OF THE WILLAMETTE MERIDIAN, OREGON.

DEPENDENT RESURVEY

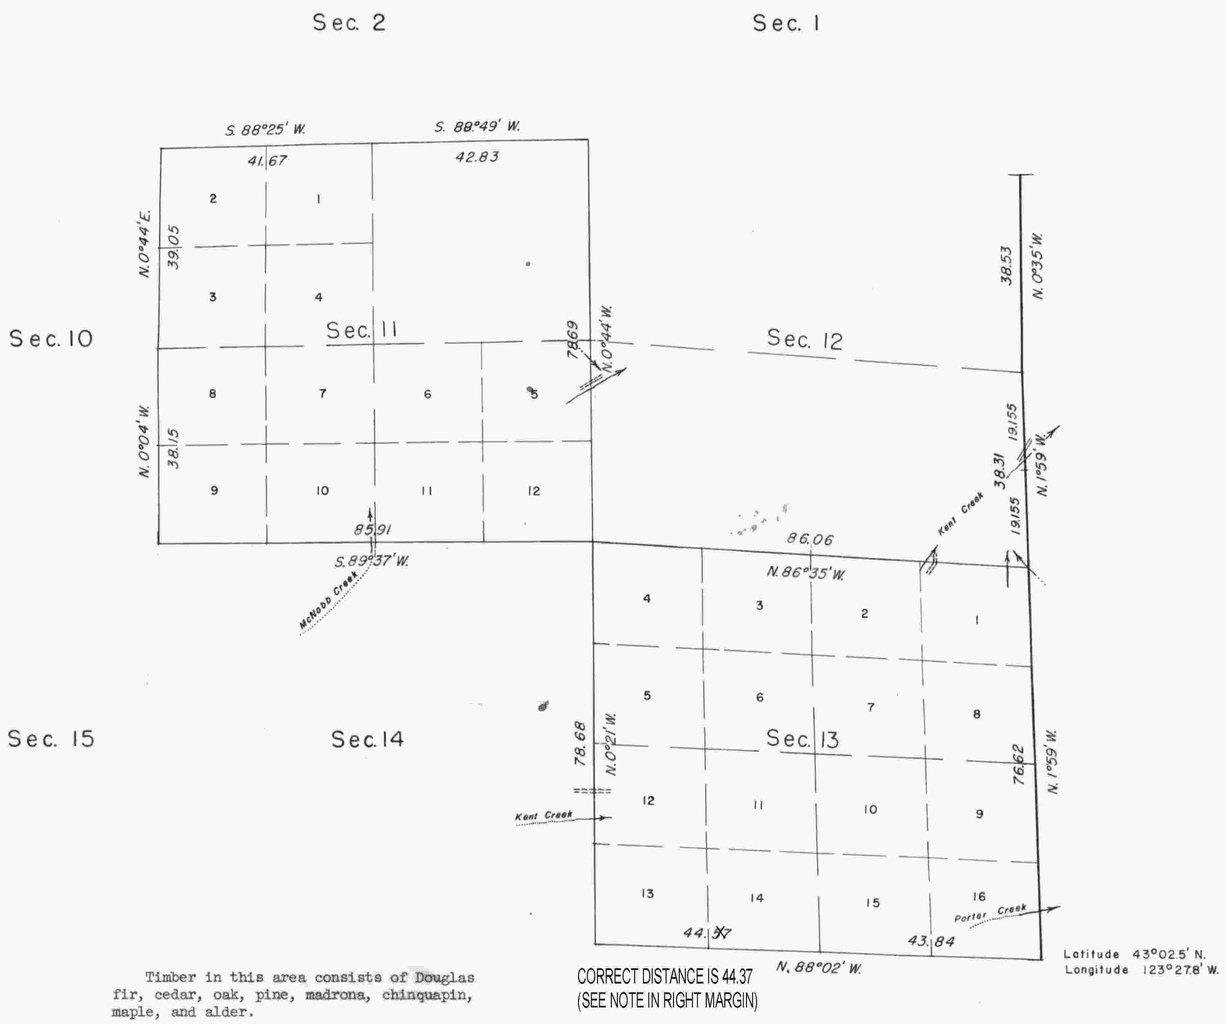

True Meridian

Mean magnetic declination

19° 43' East

Timber in this area consists of Douglas fir, cedar, oak, pine, madrona, chinquapin, maple, and alder.

CORRECT DISTANCE IS 44.37
(SEE NOTE IN RIGHT MARGIN)

Latitude 43°02.5' N.
Longitude 123°27.8' W.

This plat represents a retracement and reestablishment of a portion of the east boundary and subdivisional lines designed to restore the corners in their true original location according to the best available evidence; the lottings and areas are as shown on the plat accepted July 11, 1958.

Subsequent to the resurvey accepted July 11, 1958, the original ¼ Sec. Cor. of secs. 7 and 12, Tps. 29 S., Rs. 6 and 7 W., Willamette Meridian was recovered resulting in the reproportioning of certain corners as shown hereon.

The south boundary of Sections 13 and 14 was resurveyed by Roy T. Campbell in 1910 and retraced by Fred Mensch in 1924.

Portions of the east boundary and subdivisional lines resurveyed by Hans W. Thielsen in 1957.

Dependent resurvey of a portion of the east boundary and subdivisional lines, T. 29 S., R. 7 W., Willamette Meridian, Oregon, executed by Hans W. Theilsen, August 3 to 5, 1959, under Supplemental Special Instructions dated June 26, 1959, which provide for the surveys included under Group No. 346, Oregon.

For areas see plat, accepted July 11, 1958.

NOTE: West 1/2 of South Bdy. of Sec. 13 should be 44.37 instead of 44.57 chs. per field notes.

UNITED STATES DEPARTMENT OF THE INTERIOR
BUREAU OF LAND MANAGEMENT
Washington, D.C. February 9, 1961

This plat is strictly conformable to the approved field notes, and the survey, having been correctly executed in accordance with the requirements of law and the regualtions of this Bureau, is hereby accepted.

For the Director

Arnold B. Clement

Cadastral Engineering Staff Officer

C.A.H.

28187