TOWNSHIP 29 SOUTH, RANGE 7 WEST, OF THE WILLAMETTE MERIDIAN, OREGON

DEPENDENT RESURVEY AND SUBDIVISION OF SECTION 11

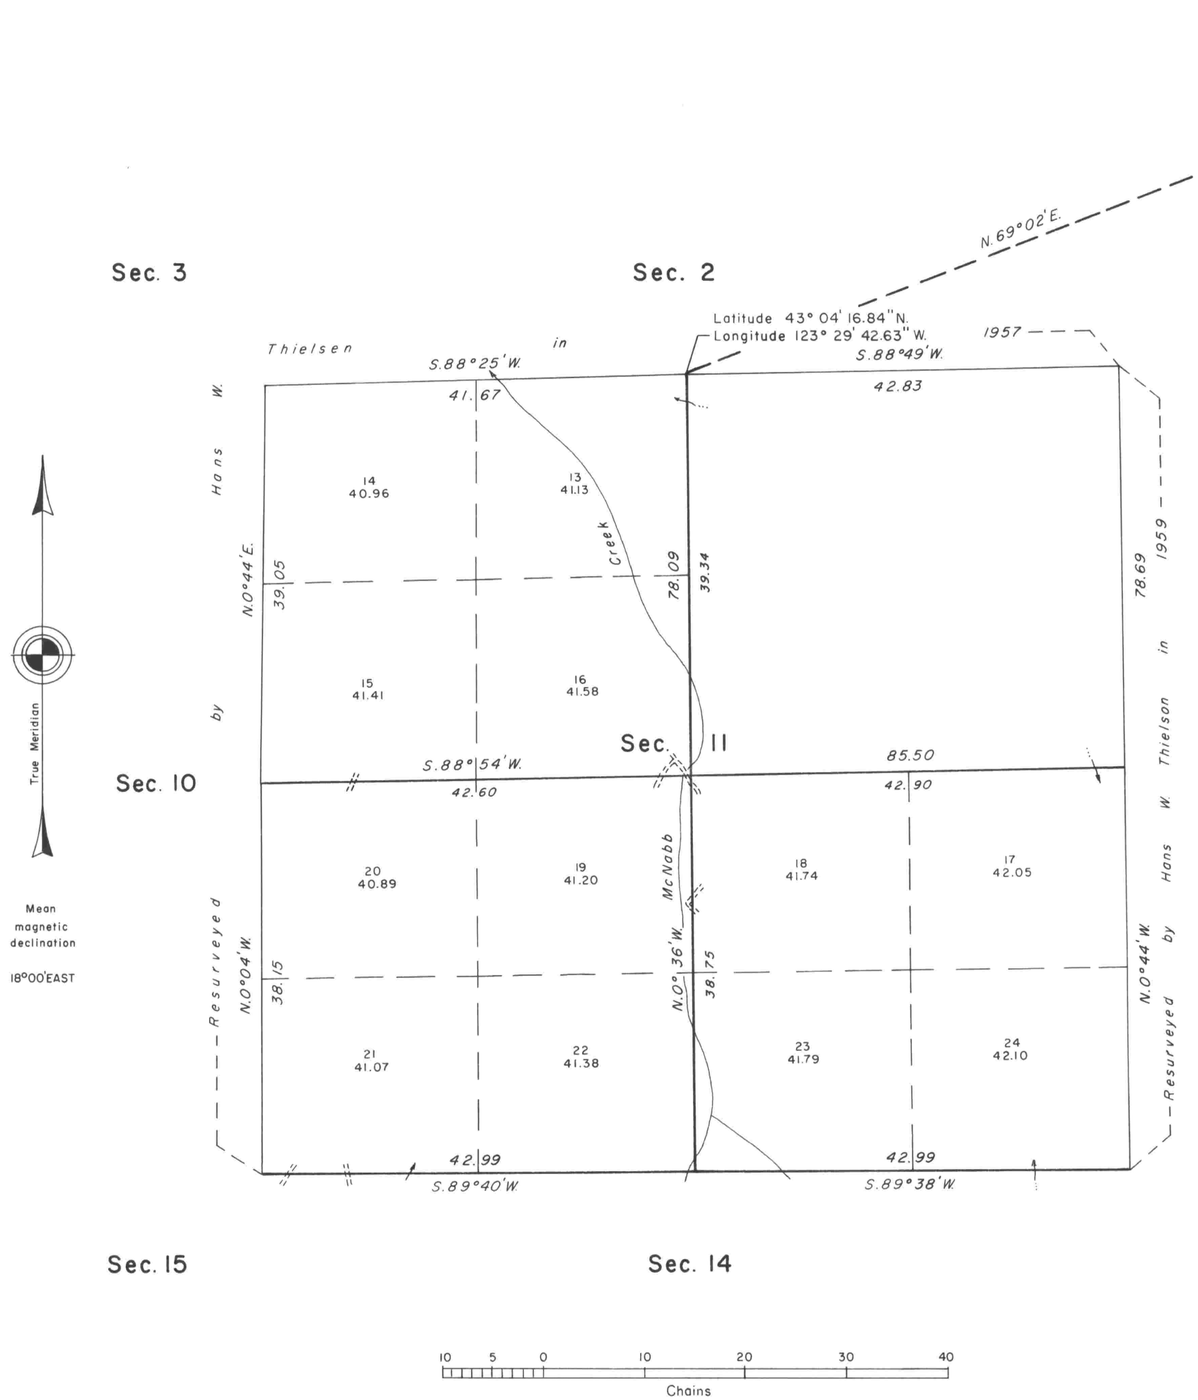

The history of surveys is contained in the field notes.

This plat represents a dependent resurvey of a portion of the subdivisional lines, T. 29 S., R. 7 W., Willamette Meridian, Oregon, designed to restore the corners in their true original locations according to the best available evidence, and the subdivision of section 11.

Except as shown hereon, the lottings and areas are as shown on the plat approved March 9, 1855.

The survey was executed by Wayne L. Rogers, Cadastral Surveyor, beginning August 8, 1984, and completed January 29, 1985, pursuant to Special Instructions dated May 1, 1984, under Group Number 1208, Oregon.

Timber in this area consists of fir, hemlock, oak, cedar, pine, maple, madrone, chinquapin, alder, ash, and yew.

UNITED STATES DEPARTMENT OF THE INTERIOR
BUREAU OF LAND MANAGEMENT
Portland, Oregon September 19, 1986

This plat is strictly conformable to the approved field notes, and the survey, having been correctly executed in accordance with the requirements of law and the regulations of this Bureau, is hereby accepted.

For the Director

William W. Glenn

Chief Cadastral Surveyor of Oregon

USA?