6325

ORIGINAL

TOWNSHIP 29 SOUTH, RANGE 7 WEST, OF THE WILLAMETTE MERIDIAN, OREGON

DEPENDENT RESURVEY, SURVEY, AND SUBDIVISION OF SECTIONS

Sec. 1 | Sec. 6 | Sec. 5

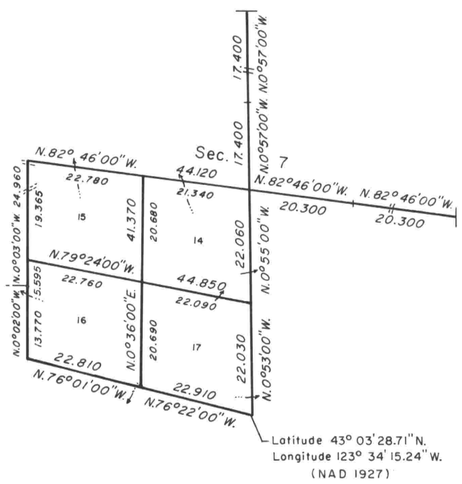

Sec. 12 | Sec. 8

A history of surveys is contained in the field notes.

This plat represents a dependent resurvey of a portion of the west boundary and subdivisional lines, T. 29 S., R. 7 W., Willamette Meridian, Oregon, designed to restore the corners in their true original locations according to the best available evidence, the subdivision of sections 7 and 19, and the survey of the location of the Oro Grande Placer Claim.

Except as shown hereon, the lottings and areas are as shown on the plats approved March 9, 1855, June 30, 1863, February 15, 1926, and the plat accepted August 28, 1980.

The survey was executed by Daniel E. Weller, and Dale T. Bedell, Cadastral Surveyors, beginning June 8, 1988, and completed February 17, 1989, pursuant to Special Instructions dated May 26, 1988, and Supplemental Special Instructions dated June 10, 1988, under Group Number 1447, Oregon.

Timber in this area consists of fir, cedar, hemlock, pine, madrone, maple, chinquapin, oak and alder.

Sec. 18 | Sec. 17

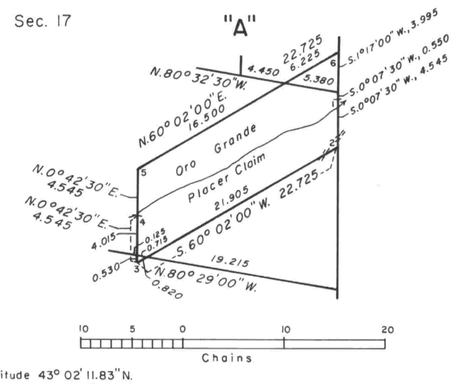

Sec. 13

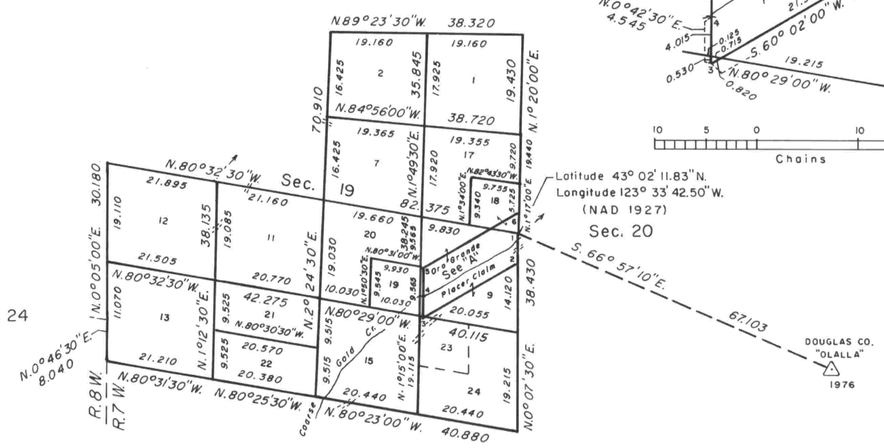

Sec. 24 | Sec. 25 | Sec. 30 | Sec. 29

10 5 0 10 20 30 40 50 60 70 80
Chains

UNITED STATES DEPARTMENT OF THE INTERIOR
BUREAU OF LAND MANAGEMENT

Portland, Oregon — June 8, 1990

This plat is strictly conformable to the approved field notes, and the survey, having been correctly executed in accordance with the requirements of law and the regulations of this Bureau, is hereby accepted.

For the Director

Wayne M. Gardner

Chief Cadastral Surveyor of Oregon

USA