TOWNSHIP 29 SOUTH, RANGE 8 WEST, OF THE WILLAMETTE MERIDIAN, OREGON

CORRECTIVE DEPENDENT RESURVEY, DEPENDENT RESURVEY AND SUBDIVISION OF SECTION 17

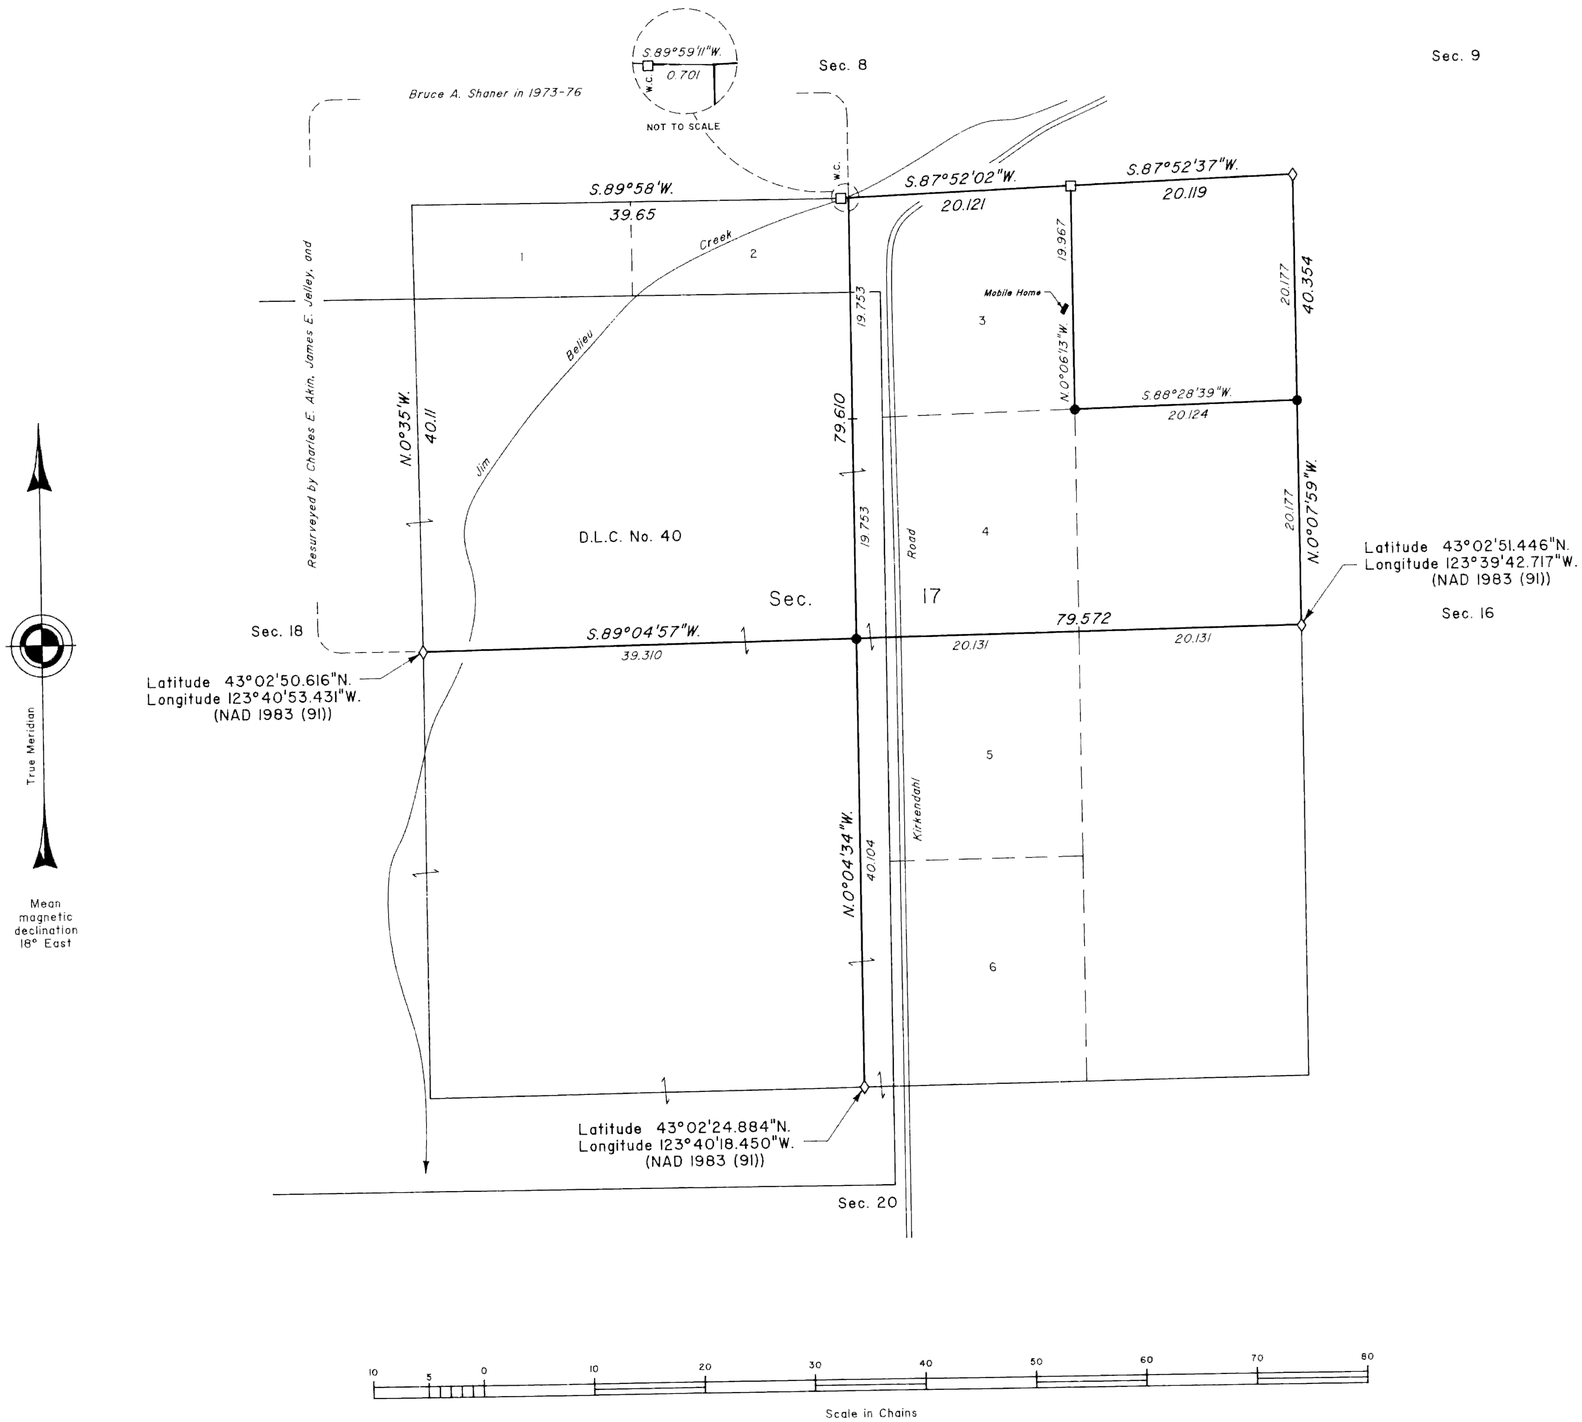

A history of surveys is contained in the field notes.

This plat represents a corrective dependent resurvey of the E 1/2 of the line between section 8 and 17, and the dependent resurvey of a portion of the subdivisional lines, T. 29 S., R. 8 W., Willamette Meridian, Oregon, designed to restore the corners in their true original locations according to the best available evidence, and the subdivision of section 17.

Measured distances and directions have been adjusted by Cadastral Measurement Management (CMM), a computer program that incorporates a least squares adjustment routine. The adjusted bearings and distances are reported to the nearest second and 0.001 chain.

The lottings and areas are as shown on the plats approved July 7, 1856 and June 30, 1863.

The survey was executed by Bryan S. Seibold, Cadastral Surveyor, and Robert H. Browning, Surveying Technician, beginning October 26, 1995, and completed November 20, 1995, pursuant to Special Instructions dated June 27, 1995, and Supplemental Special Instructions dated November 8, 1995, under Group Number 1776, Oregon.

Timber in this area consists of fir, cedar, pine, oak, madrone, maple and chinquapin.

LEGEND

- ◇ Original corner previously remonumented
- □ Corner previously established or reestablished
- ● Corner established or reestablished this survey

UNITED STATES DEPARTMENT OF THE INTERIOR
BUREAU OF LAND MANAGEMENT

Portland, Oregon — September 2, 1998

This plat is strictly conformable to the approved field notes, and the survey, having been correctly executed in accordance with the requirements of law and the regulations of this Bureau, is hereby accepted.

For the Director

Wayne R. Gardner

Chief Cadastral Surveyor of Oregon

B.S.S.