TOWNSHIP 29 SOUTH, RANGE 7 AND 8 WEST, OF THE WILLAMETTE MERIDIAN, OREGON

CORRECTIVE DEPENDENT RESURVEY

FILED
Date: 4/16/2008 By: JC
This survey consists of:
~~Map:~~ VOL. 55
~~Narrative:~~
~~Corner Rpt:~~ PAGES 21423-28
DOUGLAS COUNTY SURVEYOR

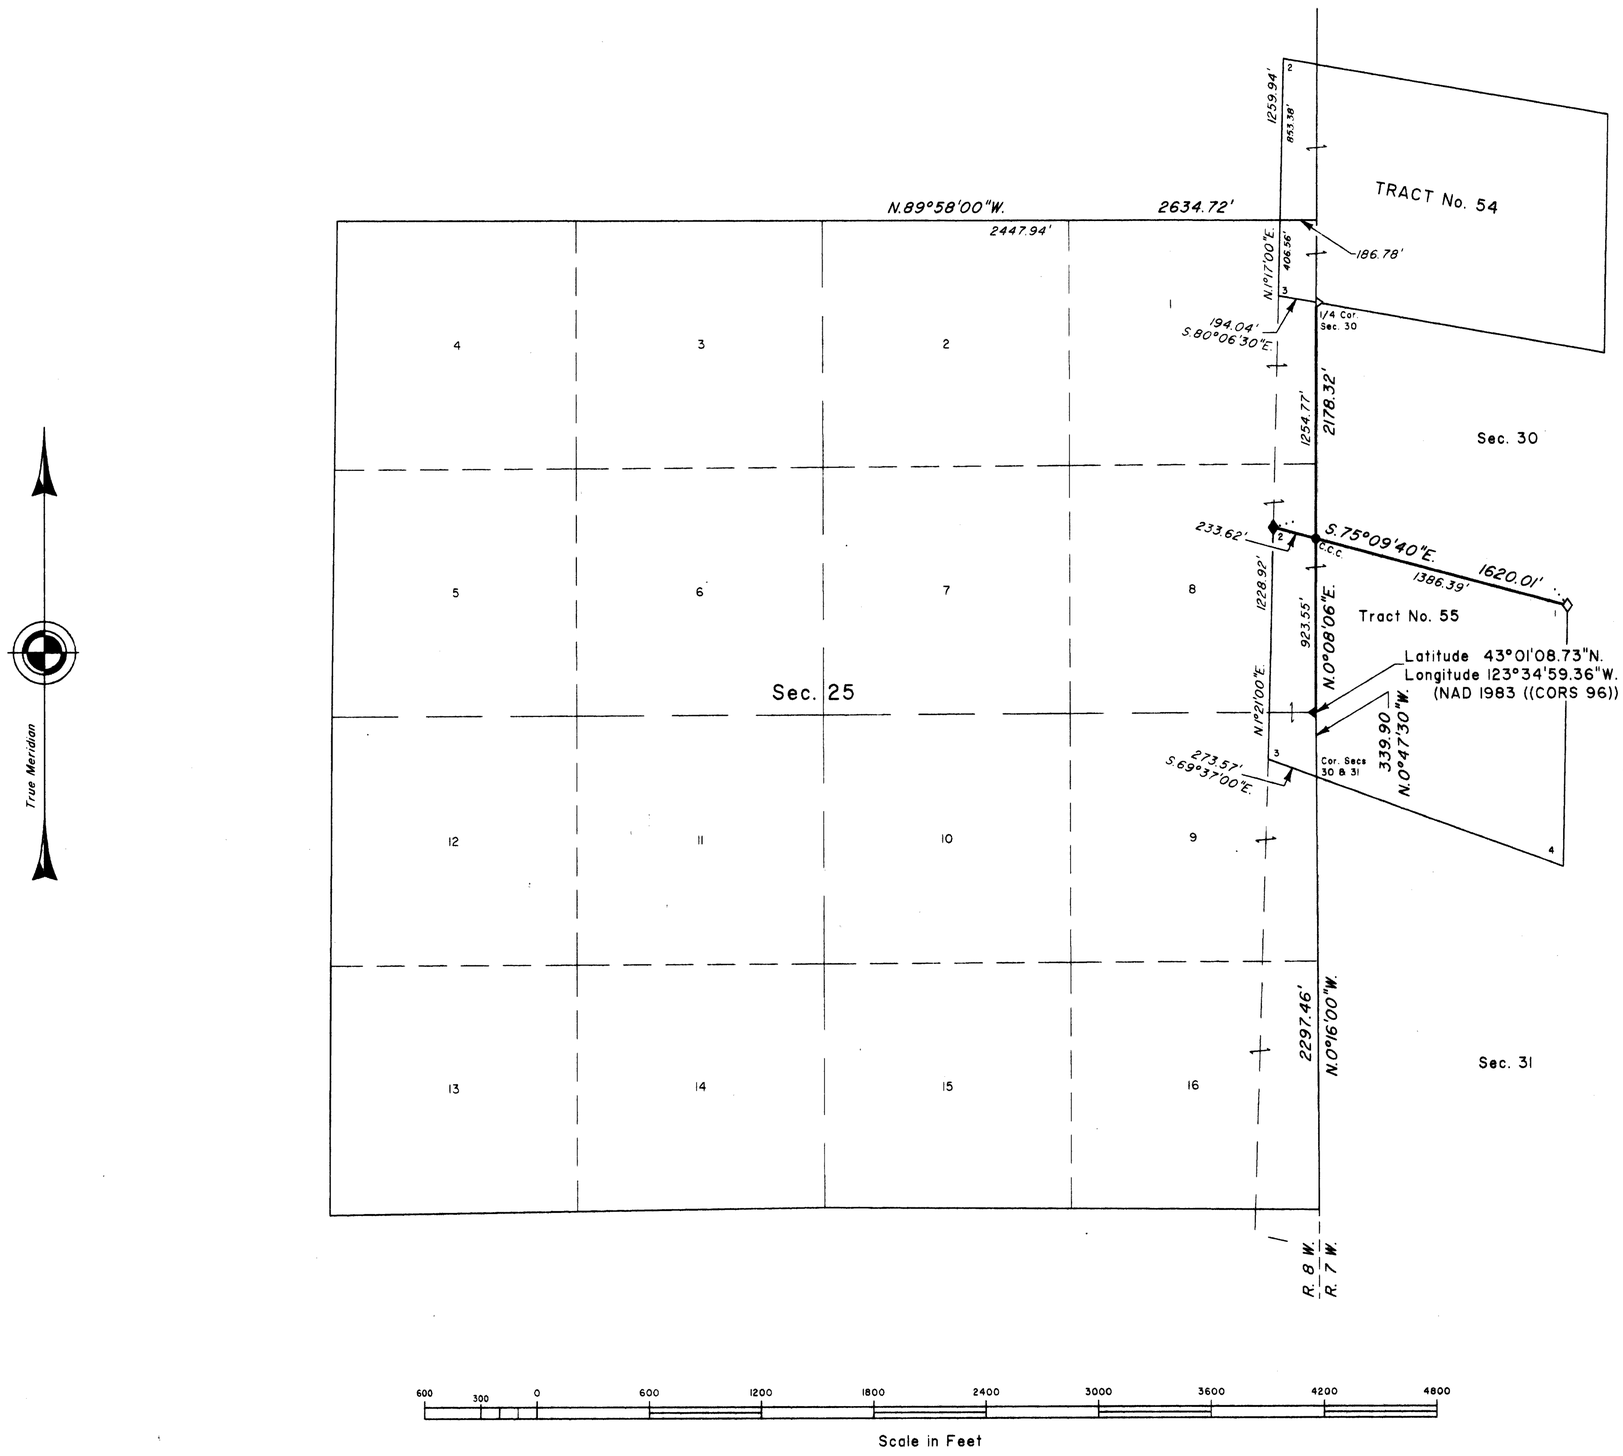

A history of surveys is contained in the field notes.

This plat represents a corrective dependent resurvey of a portion of the east boundary, T. 29 S., R. 8 W., and the north boundary of Tract 55, T. 29 S., R. 7 W. Willamette Meridian, Oregon, designed to restore the corners in their true original locations according to the best available evidence.

Measured distances and directions have been adjusted by computer software that incorporates a least squares adjustment routine. The adjusted bearings and distances are reported to the nearest second and 0.01 foot.

The lottings and areas are as shown on the plat approved February 15, 1926.

The survey was executed by Timothy J. Moore, Cadastral Surveyor, and Robert H. Browning, Surveying Technician, beginning August 14, 2006, and completed August 24, 2006, pursuant to Special Instructions dated September 20, 2004, under Group Number 2072, Oregon.

NOTE: The lightweight lines were resurveyed by Wayne L. Rogers in 1988-1989.

LEGEND

- ◇ Original corner previously remonumented
- ◆ Original corner remonumented this survey
- ● Corner established this survey

UNITED STATES DEPARTMENT OF THE INTERIOR
BUREAU OF LAND MANAGEMENT

Portland, Oregon February 8, 2008

This plat is strictly conformable to the approved field notes, and the survey, having been correctly executed in accordance with the requirements of law and the regulations of this Bureau, is hereby accepted.

For the Director

Mary J. M. Hautzel

Chief Cadastral Surveyor of Oregon

R.L.L.