


Township No. 29 South Range No. 9 West. Willamette Meridian

1275

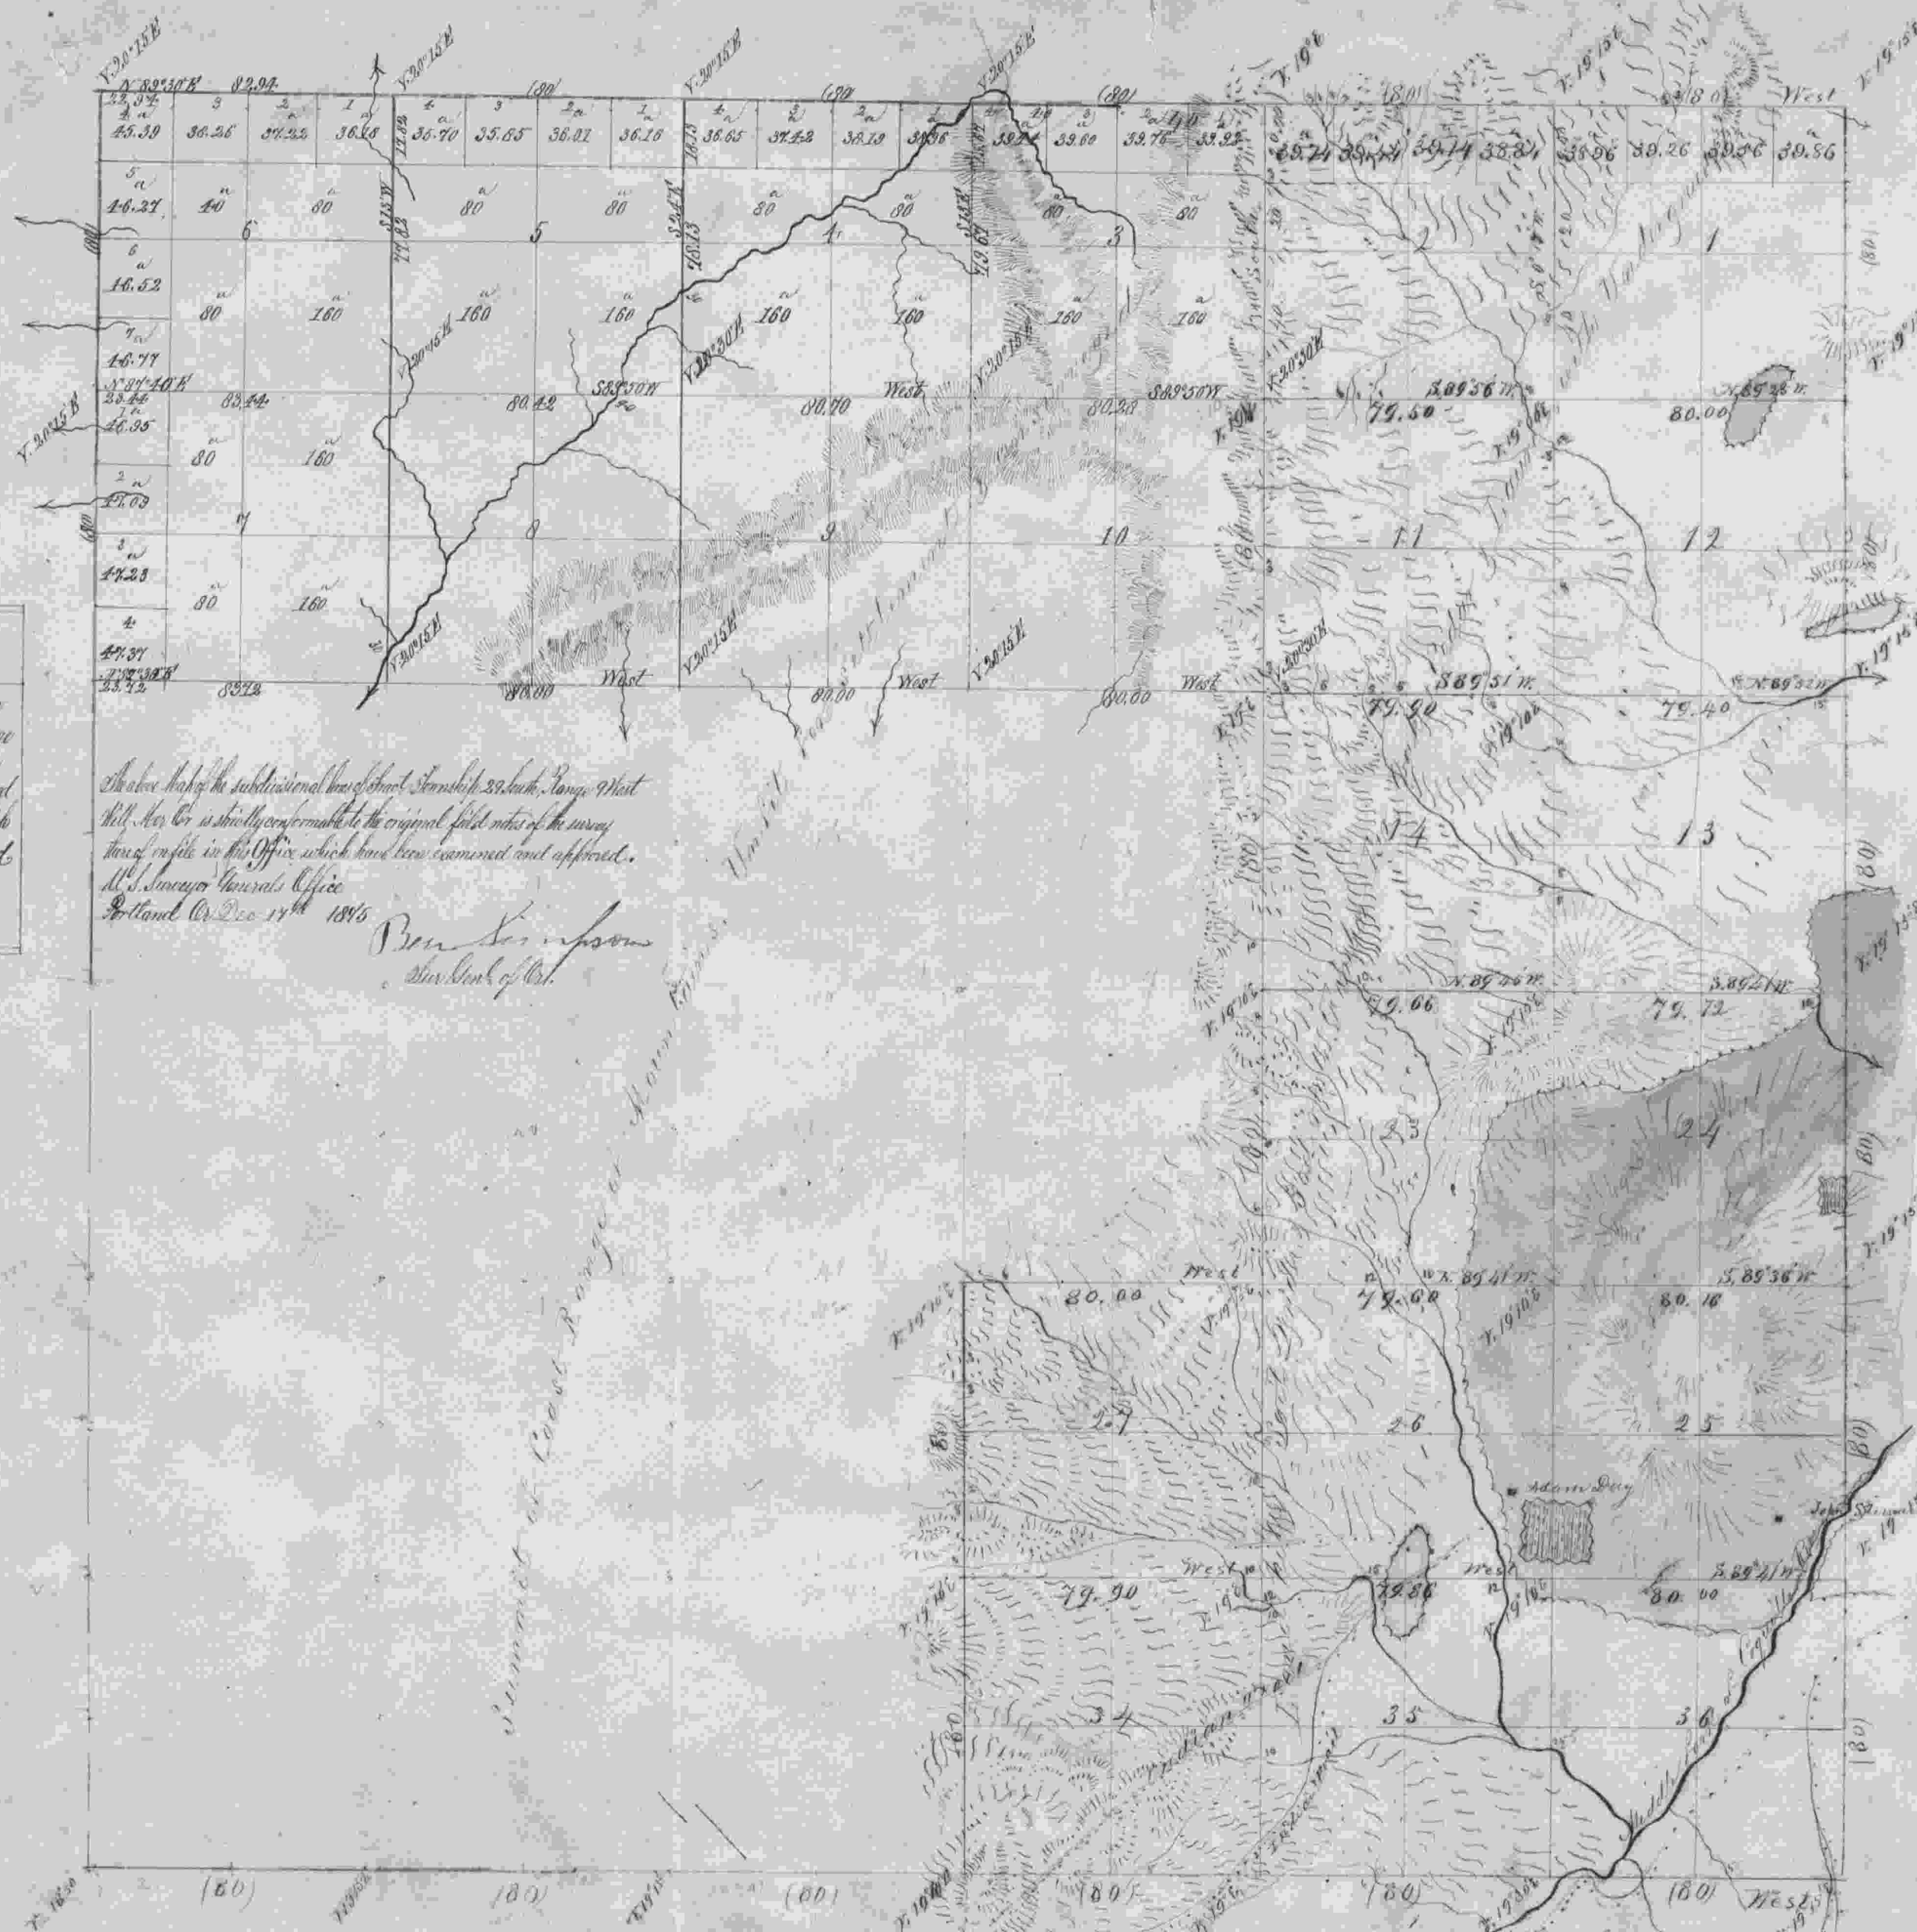

Area	
Sections	Acres
1	638.72
2	631.22
3	628.72
4	636.61
5	638.64
6	640.00
7	640.00
8	640.00
Total	5138.91

General Description

All the land surveyed in this map is on or near the summit ridge of the Coast Range of Mountains and is well adapted for growing pine, fir or spruce except the flat bottom land in the bottom along the range rivulet which flows through the central part of the land. The demand for timber may make the land valuable in the future.



Sur. Gen. of Ore.

Survey designated	By whom surveyed	No.	Date	Acres	When surveyed
Township Lines	Dennis Hathorn	57	April 12 th 1855	8 40 00	July 1 st 1856
Subdivisions	Dennis Hathorn	57	April 12 th 1855	25 77 11	July 1 st 1856
Total number of acres				3254.80	
Subdivisions	W. S. Chapman	234	June 24 1875	14 04 18	Complete 1875
Blue lines indicate former surveys					



