TOWNSHIP 29 SOUTH, RANGE 9 WEST, OF THE WILLAMETTE MERIDIAN, OREGON.

DEPENDENT RESURVEY, SUBDIVISION OF SECTIONS 11 AND 31, AND REMONUMENTATION OF CORNERS

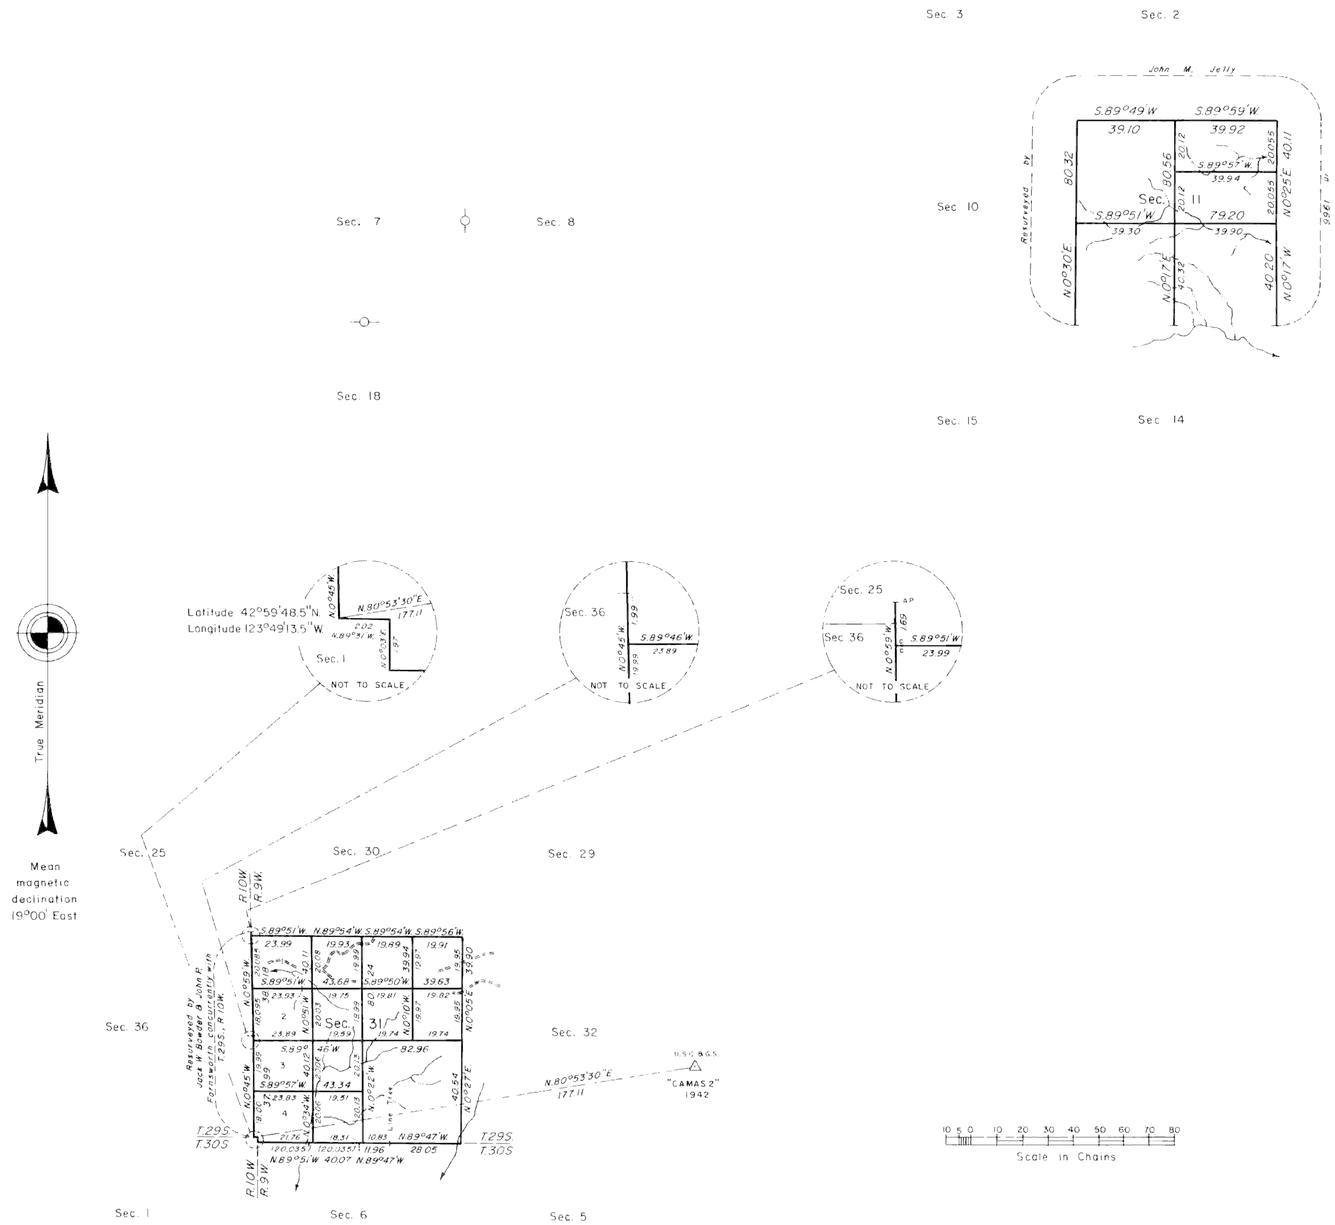

A history of surveys is contained in the field notes.

This plat represents a dependent resurvey of a portion of the north and east boundaries, T. 30 S., R. 10 W., and a portion of the south boundary and subdivisional lines, T. 29 S., R. 9 W., Willamette Meridian, Oregon, designed to restore the corners in their true original locations according to the best available evidence, and the subdivision of sections 11 and 31, and the remonumentation of certain original corner points.

The lottings and areas are as shown on the plats approved July 7, 1856 and March 19, 1909.

The survey was executed by Jack W. Bowder, John P. Farnsworth, and Wayne L. Rogers, Cadastral Surveyors, beginning May 15, 1979 and completed September 21, 1982, pursuant to Special Instructions dated April 6, 1979 and Supplemental Special Instructions dated July 20, 1979 for Group No. 976, Special Instructions dated July 13, 1979 for remonumentation under Group No. 1000, Special Instructions dated September 13, 1979 for Group No. 996, and Special Instructions dated March 8, 1982, for Group No. 1091, Oregon.

Timber in this area consists of fir, hemlock, cedar, maple, alder, chinquapin, madrone, oak, myrtle, and maple.

UNITED STATES DEPARTMENT OF THE INTERIOR
BUREAU OF LAND MANAGEMENT
Portland, Oregon December 22, 1983

This plat is strictly conformable to the approved field notes, and the survey, having been correctly executed in accordance with the requirements of law and the regulations of this Bureau, is hereby accepted.

For the Director

William W. Glenn

Chief Cadastral Surveyor of Oregon

rfb