TOWNSHIP 29 SOUTH, RANGE 9 WEST, OF THE WILLAMETTE MERIDIAN, OREGON

DEPENDENT RESURVEY AND SUBDIVISION OF SECTION 35

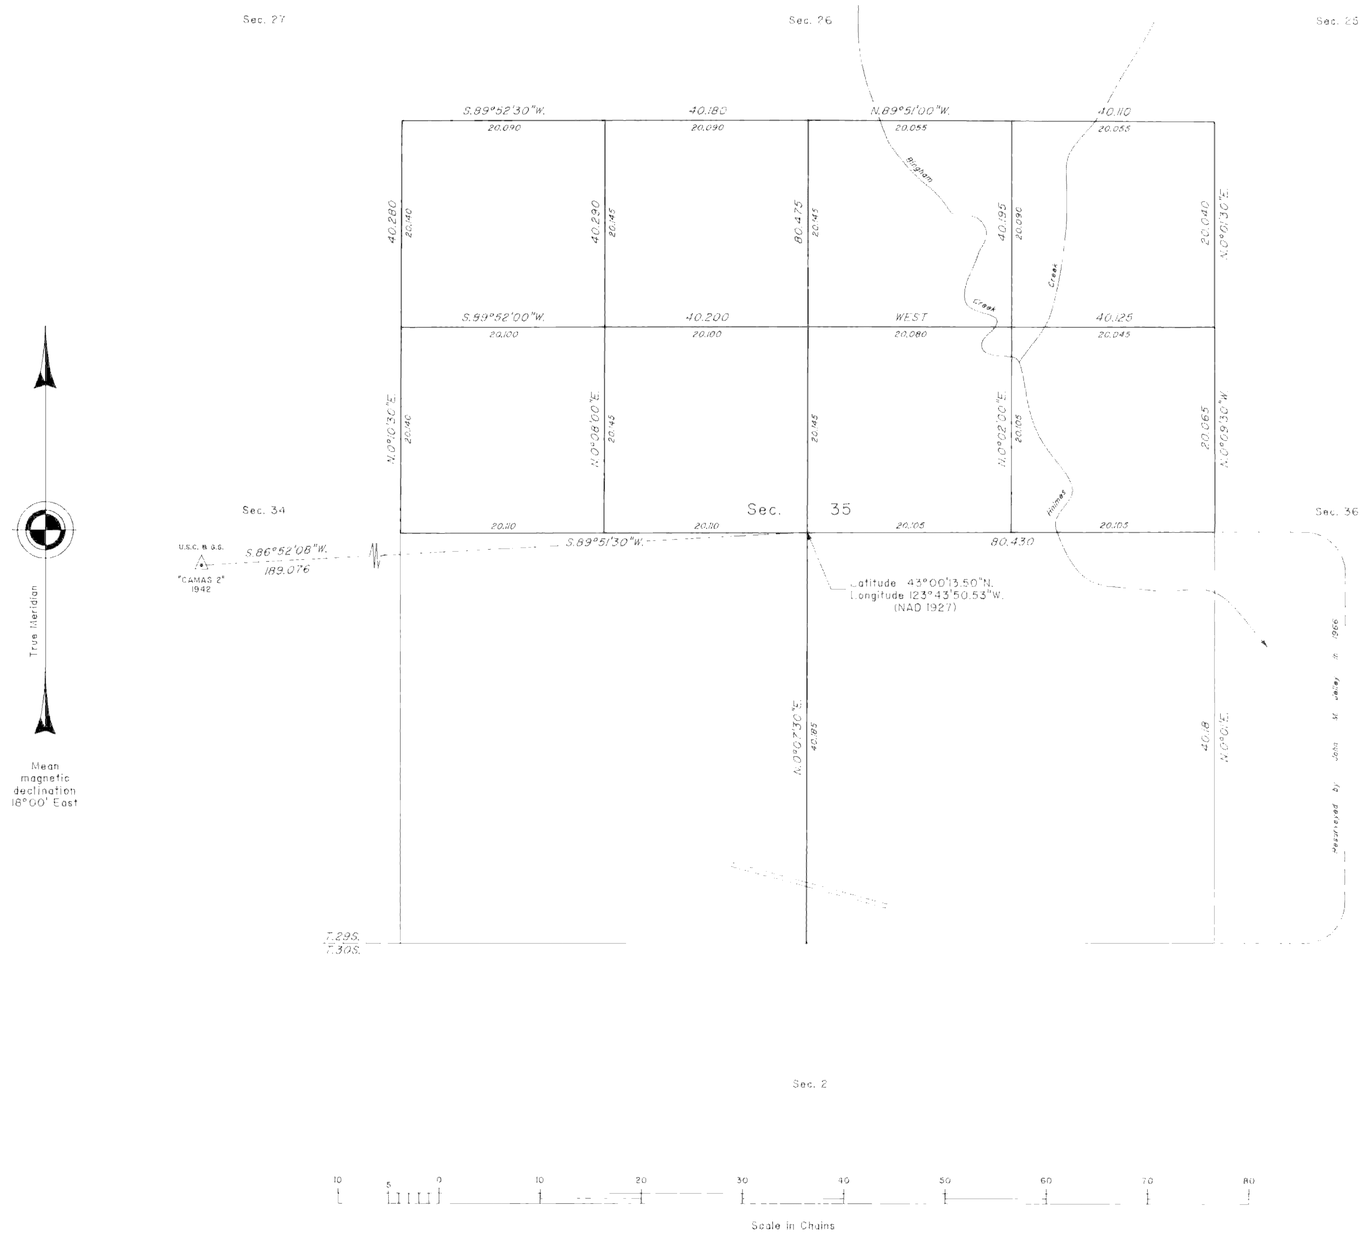

A history of surveys is contained in the field notes.

This plat represents a dependent resurvey of a portion of the subdivisional lines and the subdivision of section 35, T. 29 S., R. 9 W., Willamette Meridian, Oregon.

The areas are as shown on the plat approved July 7, 1856.

The survey was executed by Wayne L. Rogers, Cadastral Surveyor, and Garry L. Moore, Surveying Techinician, beginning December 11, 1989, and completed March 27, 1990, pursuant to Special Instructions dated November 3, 1989, under Group Number 1516, Oregon.

Timber in this area consists of fir, cedar, hemlock, yew, pine, alder, maple, oak, madrone, willow, ash and chinquapin.

UNITED STATES DEPARTMENT OF THE INTERIOR
BUREAU OF LAND MANAGEMENT

Portland, Oregon April 29, 1993

This plat is strictly conformable to the approved field notes, and the survey, having been correctly executed in accordance with the requirements of law and the regulations of this Bureau, is hereby accepted.

For the Director

Wayne M. Gardner

Chief Cadastral Surveyor of Oregon

R.S.B.