TOWNSHIP 29 SOUTH, RANGE 9 WEST, OF THE WILLAMETTE MERIDIAN, OREGON

DEPENDENT RESURVEY AND SUBDIVISION OF SECTIONS 23 AND 27

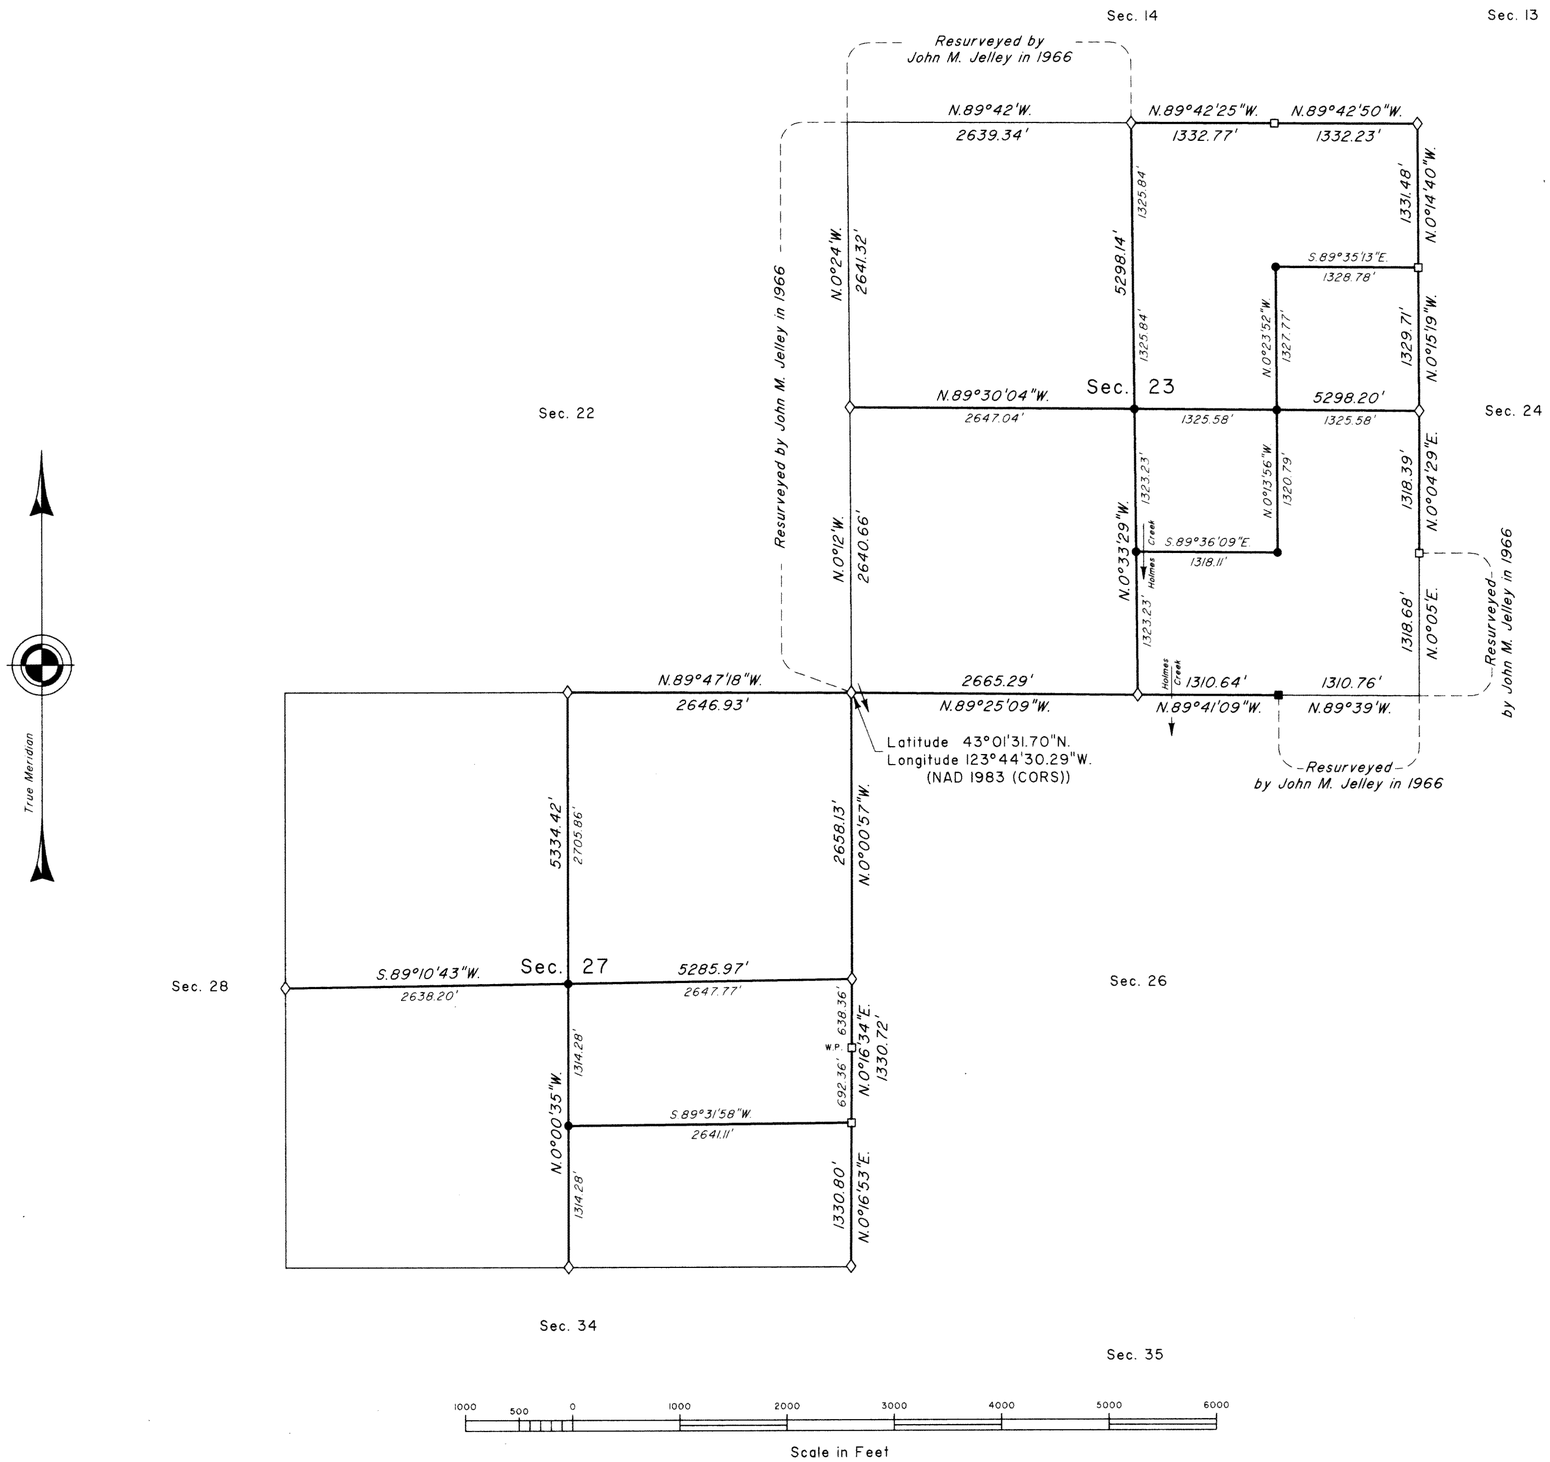

A history of surveys is contained in the field notes.

This plat represents a dependent resurvey of a portion of the subdivisional lines, T. 29 S., R. 9 W., Willamette Meridian, Oregon, designed to restore the corners in their true original locations according to the best available evidence, and the subdivision of sections 23 and 27.

Measured distances and directions have been adjusted by Trimble Geomatics Office (TGO) and Cadastral Measurement Management (CMM) for GPS and conventional measurements respectively; both are computer software which incorporates a least squares adjustment routine. The adjusted bearings and distances are reported to the nearest second and 0.01 foot.

The lottings and areas are as shown on the plat approved July 7, 1856.

The survey was executed by A. Bert Skeesick, Cadastral Surveyor, beginning May 6, 2003, and completed June 26, 2003, pursuant to Special Instructions dated March 24, 2003, under Group Number 2043, Oregon.

Timber in this area consists of fir, cedar, chinquapin, maple, madrone, and oak.

LEGEND

- ◇ Original corner previously remonumented
- □ Corner previously established or reestablished
- ■ Corner previously established or reestablished; remonumented this survey
- ● Corner established or reestablished this survey

UNITED STATES DEPARTMENT OF THE INTERIOR
BUREAU OF LAND MANAGEMENT

Portland, Oregon January 19, 2007

This plat is strictly conformable to the approved field notes, and the survey, having been correctly executed in accordance with the requirements of law and the regulations of this Bureau, is hereby accepted.

For the Director

Mary J. M. Hautala

Chief Cadastral Surveyor of Oregon

S.C.W.