

# TOWNSHIP 29 SOUTH, RANGE 9 WEST, OF THE WILLAMETTE MERIDIAN, OREGON

## RETRACEMENT

DOUGLAS COUNTY  
SURVEYOR

This plat represents the entire record of the retracement of a portion of the subdivisional lines, T. 29 S., R. 9 W., Willamette Meridian, Oregon.

A history of surveys pertaining to this retracement is as follows:

In 1875, W. S. Chapman, U.S. Deputy Surveyor, surveyed a portion of the subdivisional lines.

In 1968, Peter A. Peterson, Cadastral Surveyor, resurveyed a portion of the subdivisional lines.

In 2004-05, A. Bert Skeesick, Cadastral Surveyor, resurveyed a portion of the subdivisional lines.

This survey was executed by Aaron M. Graham, Cadastral Surveyor, beginning October 18, 2007, and completed October 25, 2007, pursuant to Special Instructions dated March 16, 2007, approved March 21, 2007, and Assignment Instructions dated October 5, 2007 under Group Number 2300, Oregon, Administrative File Number 0802. He was assisted by Keith G. Felker, Surveying Technician, and Clayton D. Thompson, Laborer.

The retracement data were thoroughly verified and only the true line field data is given hereon. Only those lines bounding or crossing public land were blazed.

The direction of the line is based on the true meridian as determined by direct solar observation.

An analysis of the unadjusted field data assured a closure not exceeding 1:4000 in error. Measured distances and directions have been adjusted by computer software that incorporates a least squares adjustment routine. The adjusted bearings and distances are reported to the nearest second and 0.01 foot.

The geodetic position shown hereon was computed from the 2004-05 survey by A. Bert Skeesick, accepted August 18, 2010.

### LEGEND

- ◊ Original corner previously remonumented
- Corner previously established or reestablished

UNITED STATES DEPARTMENT OF THE INTERIOR  
BUREAU OF LAND MANAGEMENT

Portland, Oregon


The retracement represented by this plat, having been correctly executed in accordance with the requirements of law and the regulations of this Bureau, is hereby accepted.

For the Director

*John M. Mansworth, Jr.*  
Chief Cadastral Surveyor of Oregon

*September 27, 2010*  
Date

Latitude 43°04'07.76"N.  
Longitude 123°45'41.78"W.  
(NAD 1983 (CORSS))

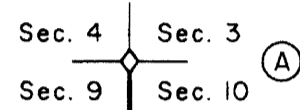

(A) The cor. of secs. 3, 4, 9, and 10, monumented with an iron post, 1 3/4 ins. diam., firmly set, projecting 16 ins. above ground, with brass cap mkd.

T29S R9W	
S 4	S 3
S 9	S 10
1959	

from which the remains of the original bearing trees

A fir stump, 62 ins. diam., bears S. 28 1/4° E., 31.7 ft. dist., with a healed blaze.

A cedar, 30 ins. diam., bears S. 58° W., 17.2 ft. dist., with a healed blaze.

and the remains of a bearing tree mkd. by James W. Byron, Deputy County Surveyor, in 1959, filed in the Douglas County Surveyors Office under C.S. No. 49/100, and reported by Peterson

A roothole bears N. 89° W., 42.2 ft. dist., alongside of which is a down hemlock, 29 ins. diam., with a healed blaze.

and the bearing trees mkd. by Peterson in 1968

A hemlock, 26 ins. diam., bears N. 18° E., 23.1 ft. dist., with a healed blaze.

A hemlock, 22 ins. diam., bears S. 37 1/2° E., 49.5 ft. dist., with a healed blaze.

and a bearing tree mkd. by Skeesick in 2004-05

A hemlock, 18 ins. diam., bears N. 10 1/2° W., 42.9 ft. dist., with scribe marks T29S R9W S4 BT visible on partially healed blaze.

(B) The 1/4 sec. cor. of secs. 9 and 10, monumented with an iron post, 2 1/2 ins. diam., firmly set, projecting 2 ins. above ground, with brass cap mkd.

1/4	
S 9	S 10
T29S R9W	
1968	

from which the bearing trees mkd. by Peterson in 1968

A cedar, 27 ins. diam., bears S. 75° E., 120.8 ft. dist., with a healed blaze.

A hemlock, 17 ins. diam., bears S. 79° W., 105.5 ft. dist., with a healed blaze. (Record, 106.3 ft. dist.)

and bearing trees mkd. by Karlas Seidel, Registered Land Surveyor No. 1845, Coos County Surveyor, in 2000, filed in the Coos County Surveyor's Office, under Book 21, page 147

A fir, 18 ins. diam., bears N. 13 1/2° E., 52.4 ft. dist., with a healed blaze.

A fir, 18 ins. diam., bears N. 43 1/2° W., 40.3 ft. dist., with a healed blaze.

I, Aaron M. Graham, Cadastral Surveyor, HEREBY CERTIFY upon honor that in pursuance of Special Instructions bearing the date of the 16th day of March, 2007, I have retraced a portion of the subdivisional lines in Township 29 South, Range 9 West, Willamette Meridian, Oregon. Said retracement has been executed in strict conformity with said Special Instructions, the Manual of Instructions for the Survey of the Public Lands of the United States, 1973, and in specific manner described on this plat.

*A. M. Graham*  
Cadastral Surveyor

*SEPT. 21, 2010*  
Date



N. 0° 07' 32" W.  
2601.84'

Sec. 9      Sec. 10  
1/4 Cor.      (B)

