TOWNSHIP 29 1/2 SOUTH, RANGE 7 WEST, OF THE WILLAMETTE MERIDIAN, OREGON

DEPENDENT RESURVEY AND SUBDIVISION OF SECTION 32

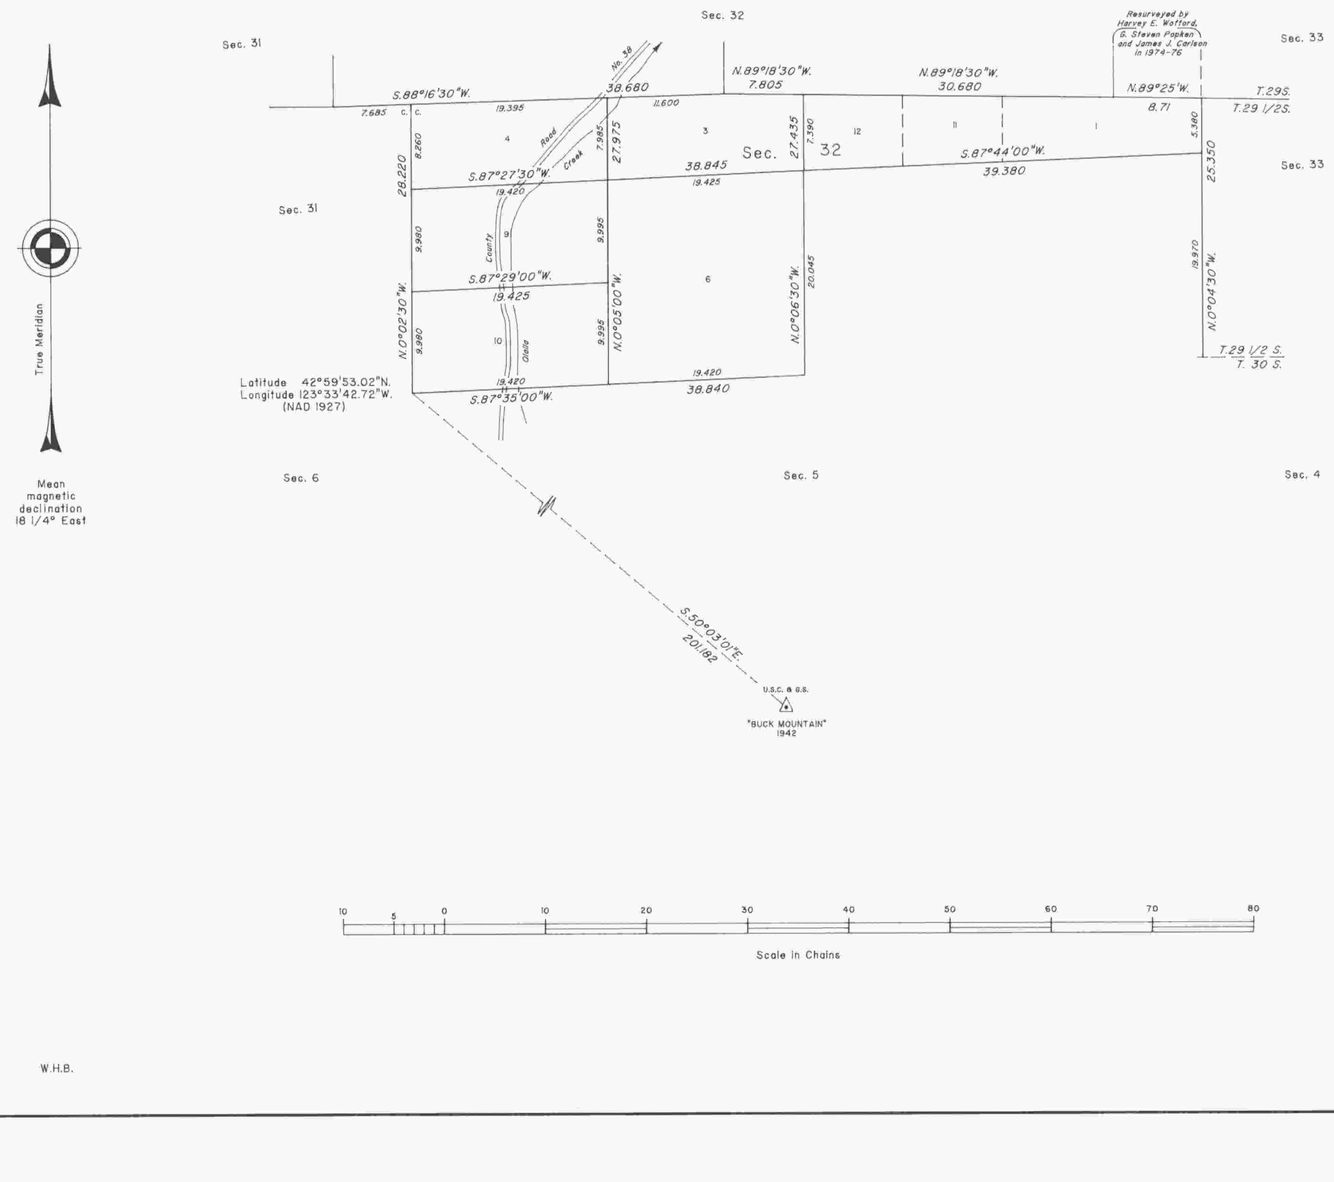

A history of surveys is contained in the field notes.

This plat represents a dependent resurvey of a portion of the south boundary of T. 29 S., R. 7 W., and a portion of the south boundary and subdivisional lines, T. 29 1/2 S., R. 7 W., Willamette Meridian, Oregon, designed to restore the corners in their true original locations according to the best available evidence, and the subdivision of section 32.

The lottings and areas are as shown on the plats approved February 15, 1926, July 20, 1928 and October 24, 1928.

The survey was executed by Boyd W. Peterson, Cadastral Surveyor, beginning September 6, 1988, and completed December 6, 1988, pursuant to Special Instructions dated August 8, 1988, and Amendment to Special Instructions dated November 30, 1988, under Group Number 1456, Oregon.

Timber in this area consists of fir, hemlock, cedar, pine, yew, oak, alder, madrone, maple and chinquapin.

UNITED STATES DEPARTMENT OF THE INTERIOR
BUREAU OF LAND MANAGEMENT

Portland, Oregon — August 26, 1992

This plat is strictly conformable to the approved field notes, and the survey, having been correctly executed in accordance with the requirements of law and the regulations of this Bureau, is hereby accepted.

For the Director

Wayne M. Gardner

Chief Cadastral Surveyor of Oregon

W.H.B.