109

# Township No. 30 South Range No. 1 West of the Willamette Meridian Oregon.

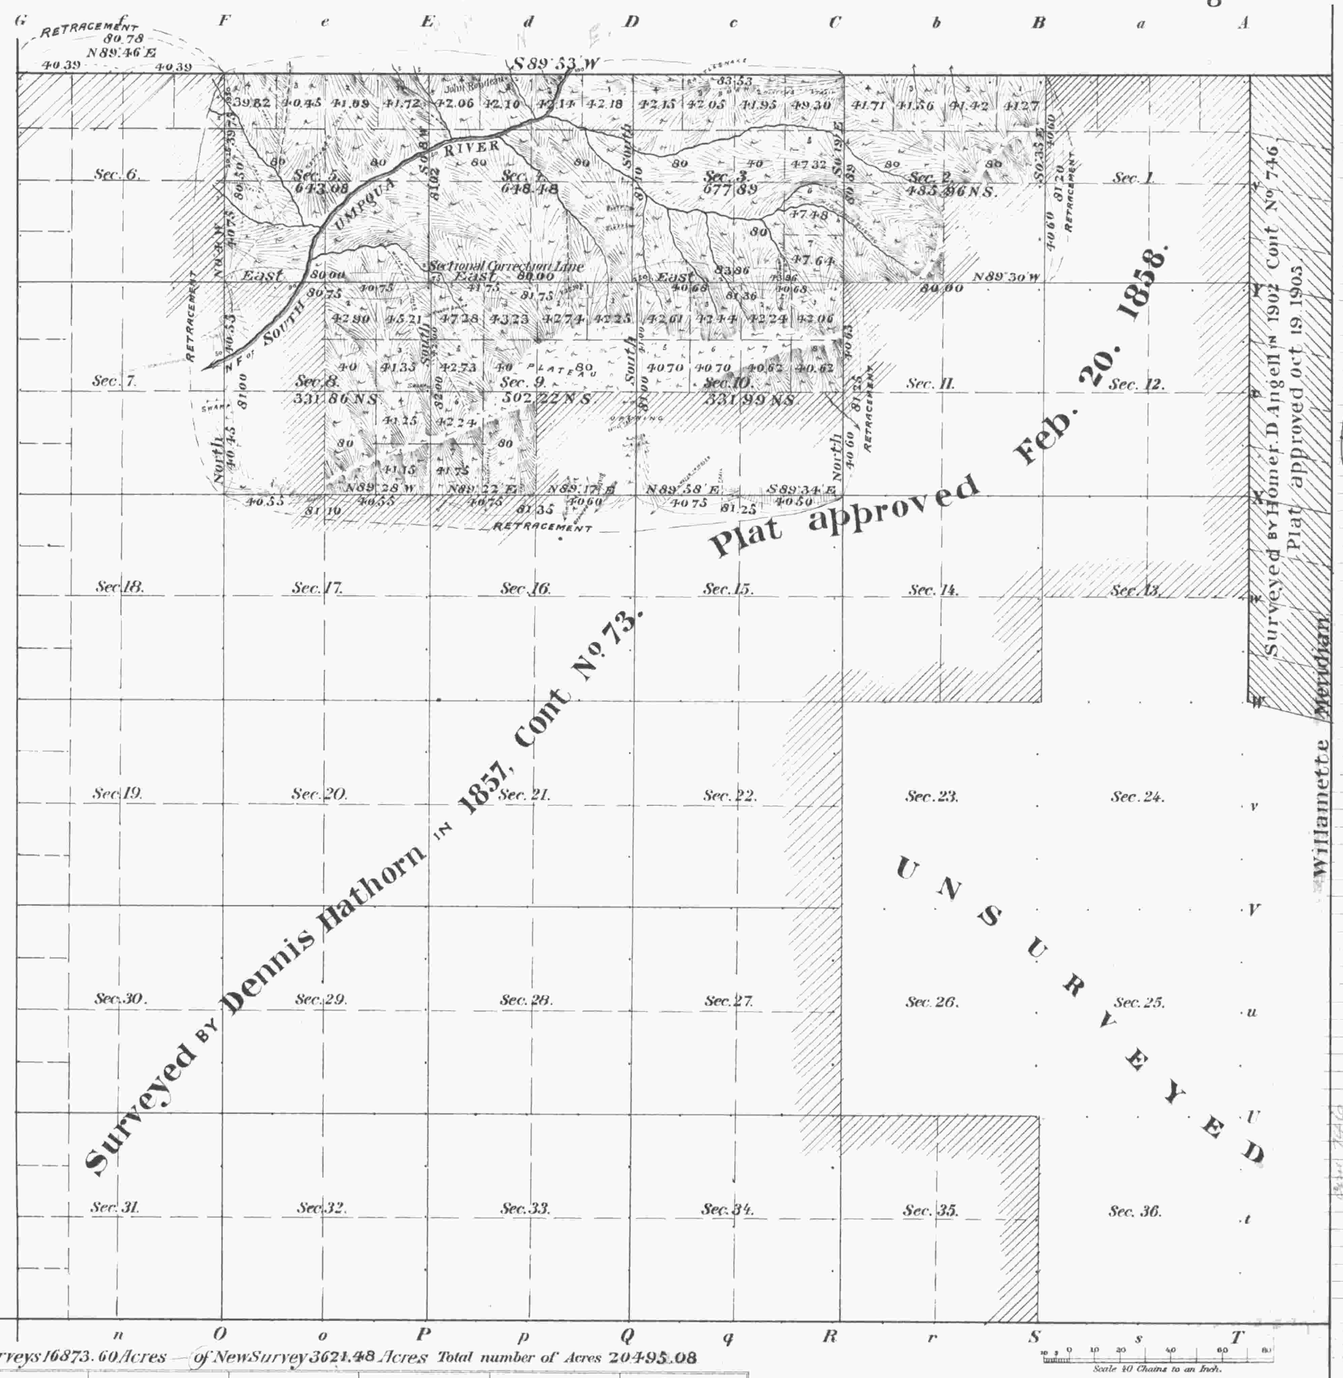


Area of Former Surveys 16873.60 Acres — of New Survey 3621.48 Acres Total number of Acres 20495.08

| Surveys Designated | By Whom Surveyed | Date of Contract | Amount of Surveys M. | Ch.s | Lk.s | When Surveyed | No. of Contract |
|---|---|---|---|---|---|---|---|
| Township lines, N. Bd. of Secs. 5 & 6 | Fred Mensch | Sept. 14. 1904 | 3 | 03 | 53 | | 757 |
| Subdivisions | " " | " " " | 8 | 09 | 87 | Aug. 9. 1905 to Nov. 11. 1907. | " |
| Correction of 1S | " " | " " " | | 3 | 23 | | " |
| Retracement of Subdivisional Lines | " " | " " " | 7 | 07 | 65 | " 8. 14 " | " |
| Retracement of N. Bd. of Sec. 6 | " " | " " " | | | | | |
| Willamette Meridian | Homer D. Angell | May 5 1902 | | | | 1902 | 746. |
| N. Bd. of Sec. 5 & 6; E. Bd. of Secs. 31, 32, 33, 34, 35 & 36 | Dennis Hathorn | June 8 1857 | | | | 1857 | 73. |

JW

The above Map of Township No. 30 South, of Range No. 1 West of the Willamette Meridian, Oregon, is strictly conformable to the field notes of the survey thereof on file in this Office, which have been examined and approved.

Surveyor General's Office,
Portland, Oregon June 29. 1906

Jno. W. Dale
Sur. Gen.l for Oregon.

Latitude 43° 00' N
Longitude 122° 51' W
Mean Mg Dec.l 21° 15' E

½ mile E. of Cor. of Tps 29 & 30 S. Rgs 1 & 2 W

...nders of

| Courses | Ch.s Lk.s | Posts | Courses | Ch.s Lk.s | Posts | Courses | Ch.s Lk.s |
|---|---|---|---|---|---|---|---|

ACCEPTED BY THE HON. COMMISSIONER G. L. O.

Feb 27 1909

The above Map of Township No. 30 South, Range No. 1 West of the Willamette Meridian Oregon, has been amended, and is strictly conformable to the field notes of the corrections thereof which have been examined, approved and filed in this Office, done by order of Hon. Com-missioners Letter "E" dated April 30. 1907.

Surveyor-General's Office
Portland, Oregon Nov. 25. 1908

Geo. A. Lamont
Sur. General for Oregon