Township No. 30 South Range No. 2 West of the Willamette Meridian Oregon

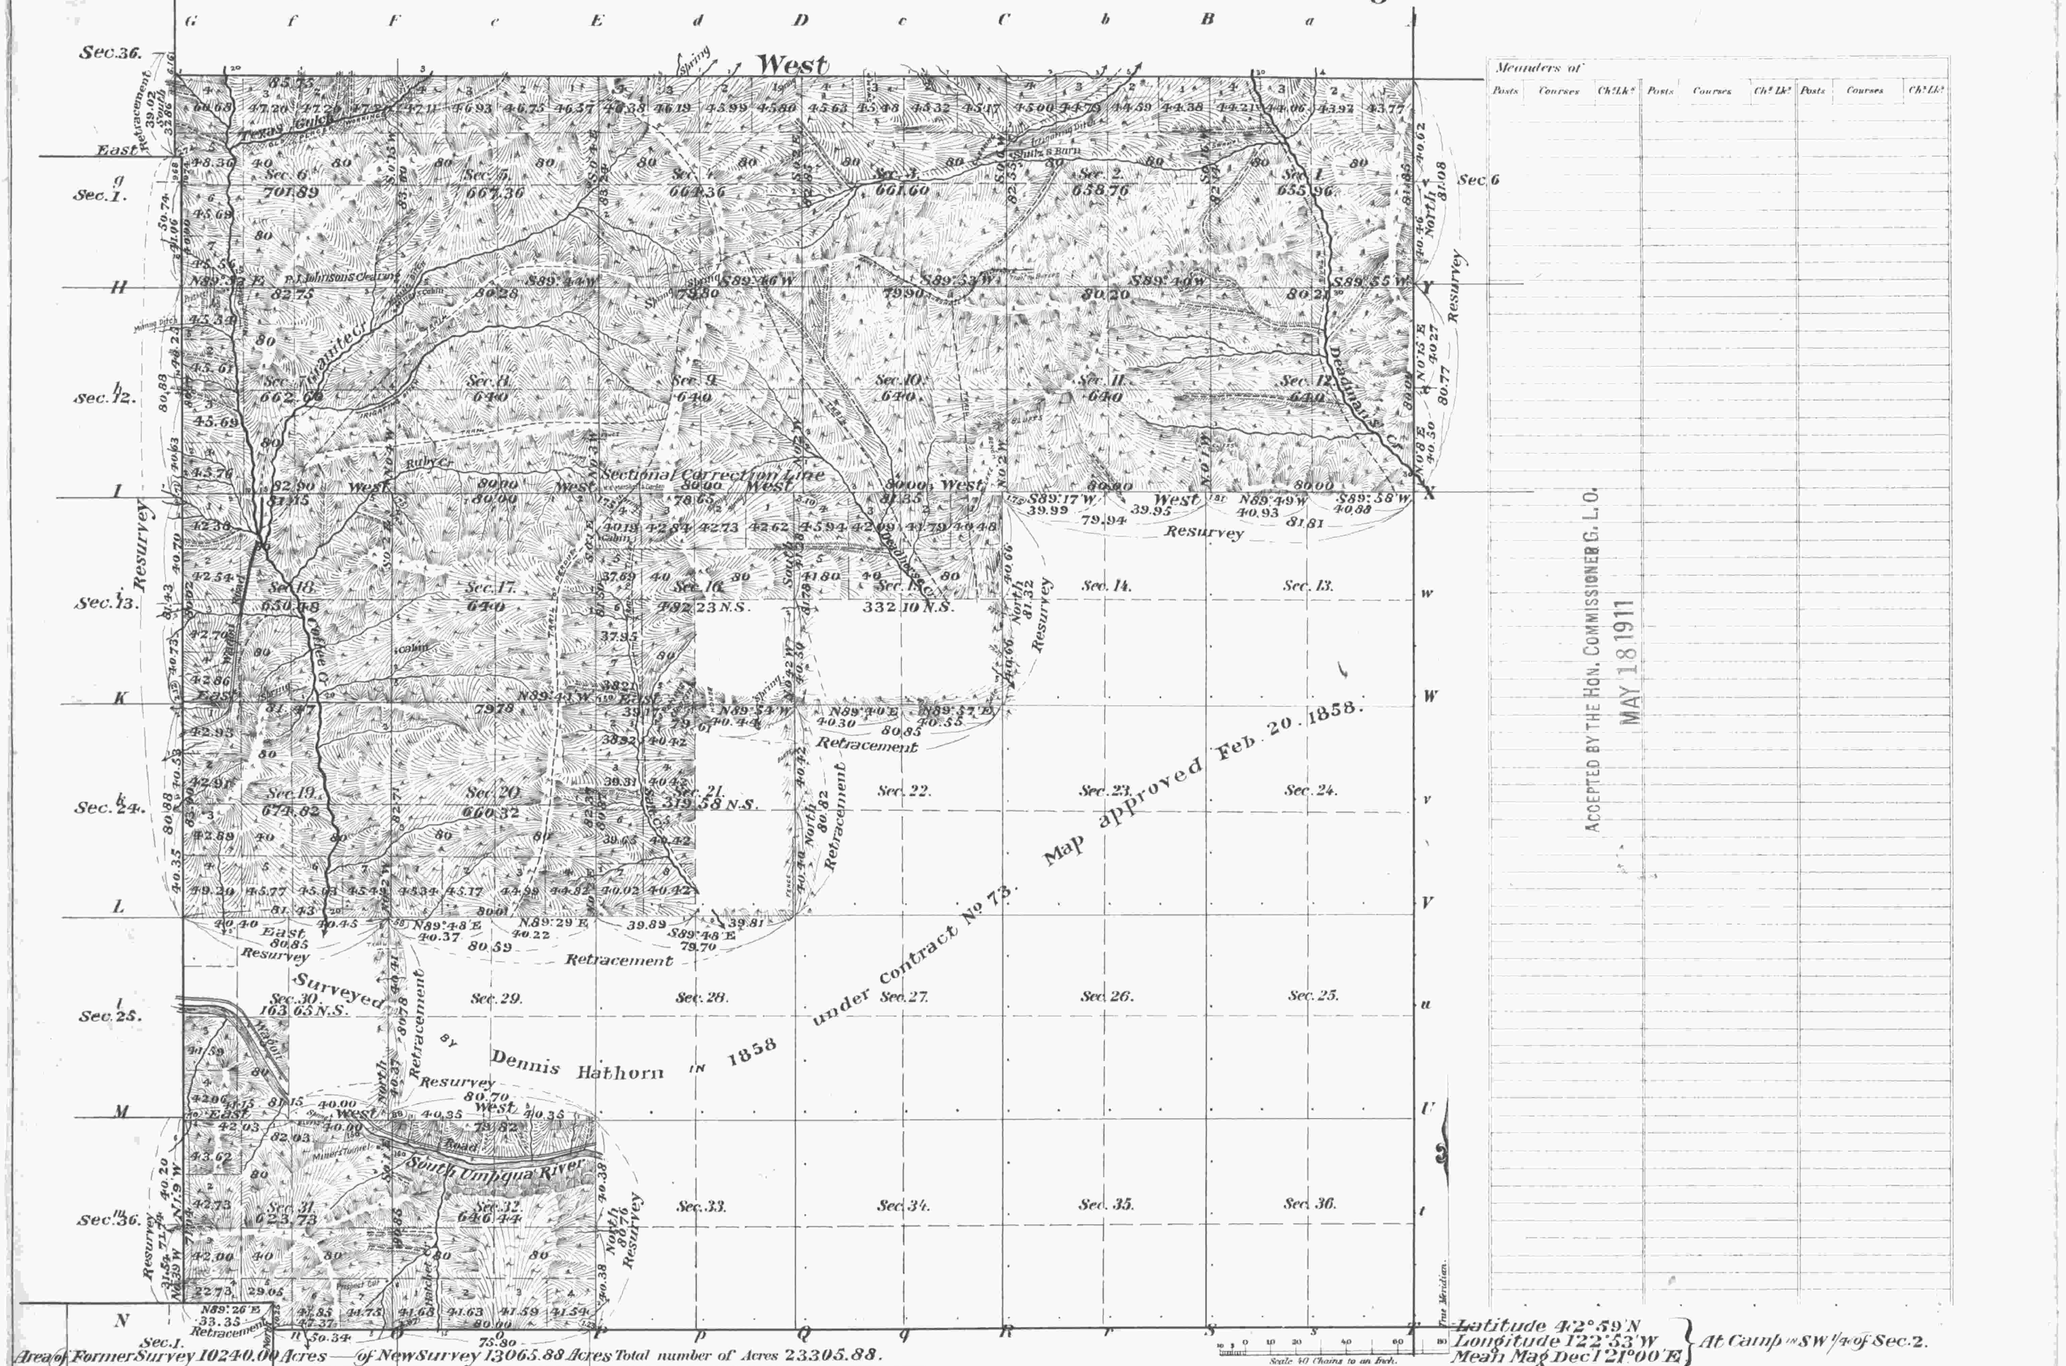

Meanders of

Posts	Courses	Ch'Lk's	Posts	Courses	Ch'Lk's	Posts	Courses	Ch'Lk's

ACCEPTED BY THE HON. COMMISSIONER G. L. O.
MAY 18 1911

Latitude 42° 59' N
Longitude 122° 53' W } At Camp in SW 1/4 of Sec. 2.
Mean Mag Dec 1 21° 00' E

Area of Former Survey 10240.00 Acres — of New Survey 13065.88 Acres Total number of Acres 23305.88.

Surveys Designated R.3 W.	Sec.6 By Whom Surveyed R.2 W.	Sec.5 Date of Contract	Amount of Surveys M. Ch's. Lk's.	When Surveyed	No. of Contract
Township lines North Boundary	Fred Mensch	December 1. 1908			782
Subdivisions			28 . 69 . 20	Aug 15 to Sep 5. 1909	
Resurveys & Subdivisions	"	"	6 . 45 . 09		"
Retracements	"	"	6 . 03 . 10		"
Connections	"	"	6 . 49		"
Resurvey of 2.00 in Sec 1 T 2 S R 3 W & 34 T 30 S R 3 W on E. Bdy			6 . 46 . 82		
Sec 1 and 12 T 30 S R 2 W			68 . 95		
Retracement of Subdivisions on E. Bdy of Sec 33 & 7 T 30 S R 2 W	Fred. Mensch	May 10. 1906		1906 and 1908	766
W. 1/2 of Sec. 31 and S 1/2 of Sec. 30	Wm M. Bushey	June 17. 1893		1893.	620
E. Bdy of Tp. & Subdivisions	Dennis Hathorn	June 8, 1857.		1858	73
(33.38 chs. on E. Bdy of Sec. 19 and N. 1/2 of Sec. 30)					

The above Map of Township No. 30 South of Range No. 2 West of the Willamette Meridian Oregon is strictly conformable to the field notes of the survey thereof on file in this Office, which have been examined and approved.

Surveyor Generals Office, Portland, Oregon Oct. 14. 1910 | Geo. W. Wright Sur. Gen. for Oregon

Gold in Quartz and Placer Deposits, are found in this Tp. especially in Sections 5, 6, 7, and 8. Mining having been carried on along Coffee Cr. and Texas Gulch for some 30 years. Gold and Copper are also found along the South Umpqua River.

J.W.