5491

ORIGINAL

TOWNSHIP 30 SOUTH, RANGE 2 WEST, OF THE WILLAMETTE MERIDIAN, OREGON.

DEPENDENT RESURVEY AND SUBDIVISION OF SECTION 7

Sec. 1 | Sec. 6 | Sec. 5

Sec. 12 | Sec. 8

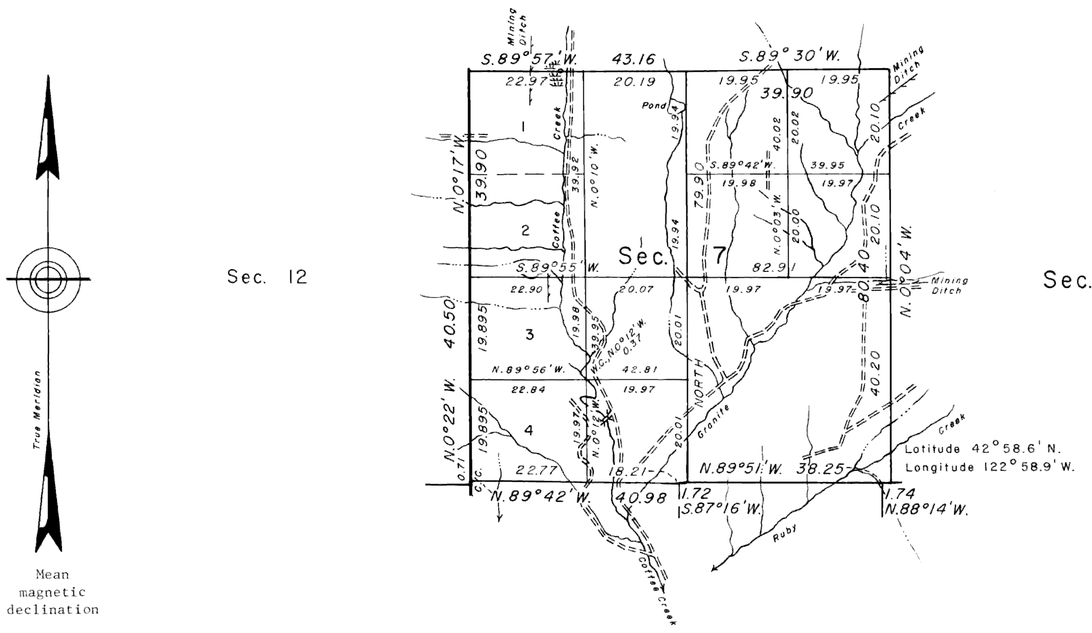

Sec. 13 | Sec. 18 | Sec. 17

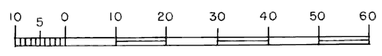

Area resurveyed: 662.60 acres

Timber in this area consists of fir, yellow pine, sugar pine, cedar, oak, maple, alder, madrone, dogwood, chinquapin, and yew.

This plat represents a dependent resurvey of a portion of the west boundary and a portion of the subdivisional lines designed to restore the corners in their original locations according to the best available evidence, and, the survey of the subdivision of Section 7 in T. 30 S., R. 2 W., Willamette Meridian, Oregon.

Except as indicated hereon, the lottings and areas are as shown on the plat approved October 14, 1910.

A portion of the west boundary was surveyed by William M. Bushey in 1893-94.

Fred Mensch resurveyed a portion of the west boundary and surveyed the subdivisional lines in 1909.

The resurvey and subdivision of section 7 were executed by Harvey E. Wofford, Cadastral Surveyor, from September 1 to October 6, 1970, under Special Instructions dated August 24, 1970, which provide for the surveys included under Group No. 705, Oregon.

UNITED STATES DEPARTMENT OF THE INTERIOR
BUREAU OF LAND MANAGEMENT
Washington, D.C. April 20, 1972

This plat is strictly conformable to the approved field notes, and the survey, having been correctly executed in accordance with the requirements of law and the regulations of this Bureau, is hereby accepted.

For the Director

Clark L. Gumm

Chief, Division of Cadastral Survey

RJL