ORIGINAL

TOWNSHIP 30 SOUTH, RANGE 2 WEST, OF THE WILLAMETTE MERIDIAN, OREGON.

DEPENDENT RESURVEY AND SUBDIVISION OF SECTION 6

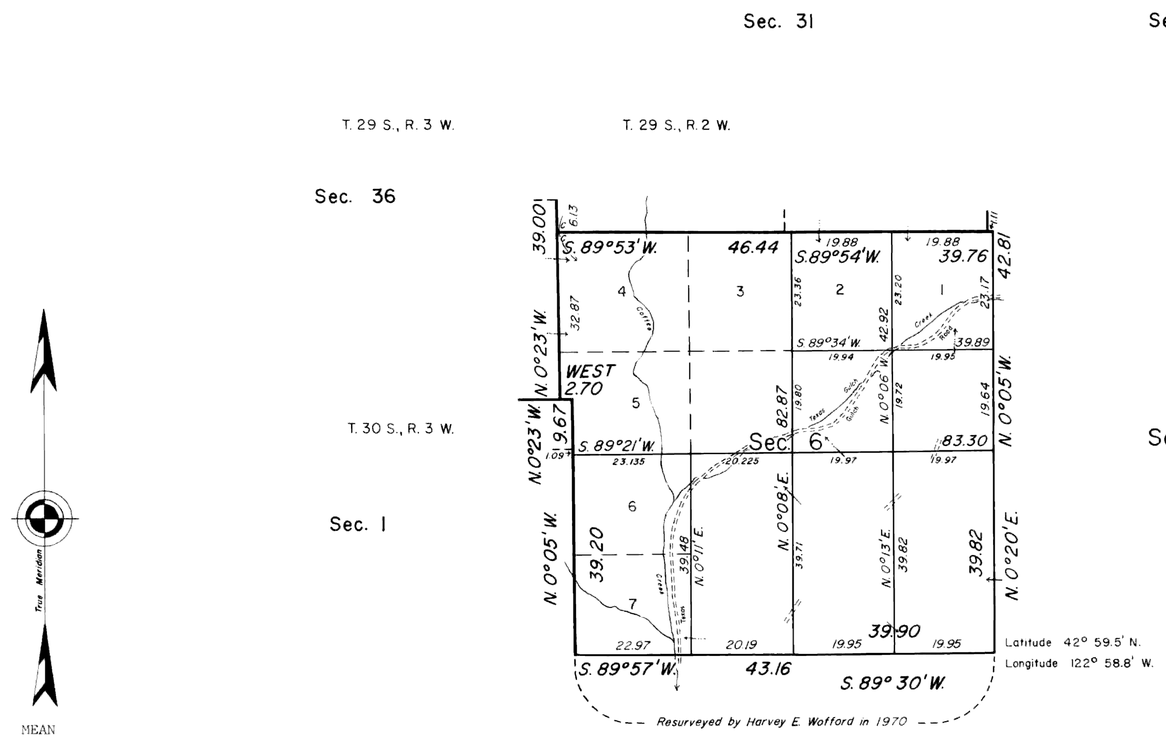

This plat represents a retracement and re-establishment of a portion of the west and north boundaries and subdivisional lines, T. 30 S., R. 2 W., Willamette Meridian, Oregon, designed to restore the corners in their true original location according to the best available evidence; and subdivision of section 6.

The lottings and areas are as shown on the plat approved October 14, 1910.

A portion of the west boundary was surveyed by William M. Bushey, in 1893-94.

A portion of the west boundary was resurveyed and the north boundary and a portion of the subdivisional lines wers surveyed by Fred Mensch, in 1909.

The north boundary was resurveyed by Elmer F. Strickler, in 1917.

A portion of the west boundary and subdivisional lines were resurveyed and section 7 was subdivided, by Harvey E. Wofford, in 1970.

The resurvey and subdivision of section 6 were executed by Peter A. Peterson and Daniel L. Berry, Cadastral Surveyors from July 26, 1971 to August 25, 1971 under Special Instructions dated June 29, 1971, which provide for the surveys included under Group No. 749, Oregon.

UNITED STATES DEPARTMENT OF THE INTERIOR
BUREAU OF LAND MANAGEMENT
Washington, D.C. October 7, 1975

This plat is strictly conformable to the approved field notes, and the survey, having been correctly executed in accordance with the requirements of law and the regulations of this Bureau, is hereby accepted.

For the Director

Bernard W. Stokes
Chief, Division of Cadastral Survey

10 0 10 20 30 40
Chains

Timber in this area consists of fir, pine, cedar, oak, maple, alder, madrone, dogwood, chinquapin, and yew.

JK