TOWNSHIP 30 SOUTH, RANGE 2 WEST, OF THE WILLAMETTE MERIDIAN, OREGON

DEPENDENT RESURVEY AND SUBDIVISION OF SECTION 29

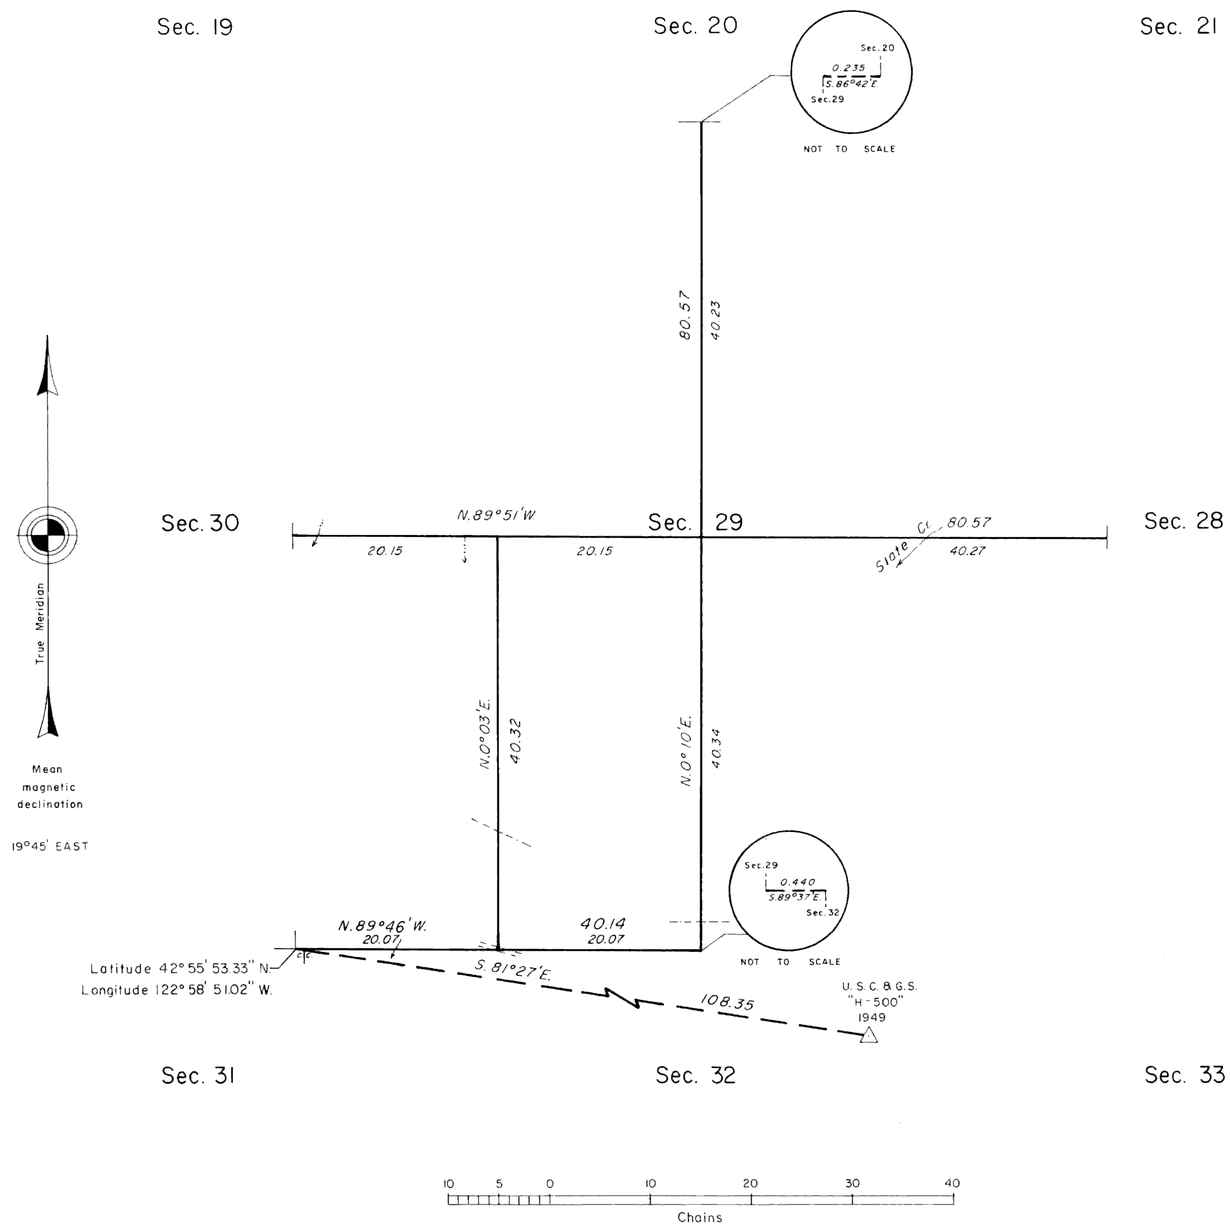

A history of surveys is contained in the field notes.

This plat represents a dependent resurvey of a portion of the subdivisional lines, T. 30 S., R. 2 W., Willamette Meridian, Oregon, and the subdivision of section 29.

The lottings and areas are as shown on the plat approved February 20, 1858.

The survey was executed by Wayne L. Rogers and Lance J. Bishop, Cadastral Surveyors, beginning May 12, 1983, and completed June 6, 1983, pursuant to Special Instructions dated December 15, 1982, under Group No. 1132, Oregon.

Timber in this area consists of pine, fir, madrone, oak, hemlock, yew, alder, cedar, maple, and chinquapin.

UNITED STATES DEPARTMENT OF THE INTERIOR
BUREAU OF LAND MANAGEMENT
Portland, Oregon April 5, 1985

This plat is strictly conformable to the approved field notes, and the survey, having been correctly executed in accordance with the requirements of law and the regulations of this Bureau, is hereby accepted.

For the Director

William W. Glenn

Chief Cadastral Surveyor of Oregon

USA