5406

ORIGINAL

TOWNSHIP 30 SOUTH, RANGE 3 WEST, OF THE WILLAMETTE MERIDIAN, OREGON.

DEPENDENT RESURVEY

This plat represents a retracement and reestablishment of the line between sections 3 and 4, T. 30 S., R. 3 W., Willamette Meridian, Oregon, designed to restore the corners in their true original locations according to the best available evidence.

A portion of the subdivisional lines were surveyed by William M. Bushey in 1893.

The resurvey was executed by Lynn M. Roseberry, Cadastral Surveyor, beginning October 26, 1967, and completed October 27, 1967, under Special Instructions dated August 25, 1965, and Supplemental Special Instructions dated October 24, 1967, which provide for the surveys included under Group No. 599, Oregon.

Sec. 32 | Sec. 33 | Sec. 34

T. 29 S., R. 3 W.

Mean
Magnetic
Declination
18°15' East

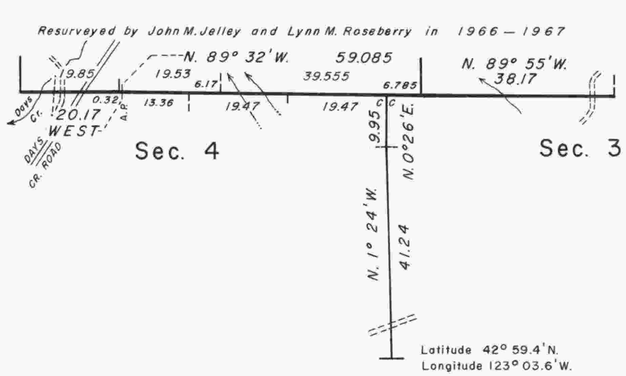

Sec. 9 | Sec. 10

UNITED STATES DEPARTMENT OF THE INTERIOR
BUREAU OF LAND MANAGEMENT
Washington, D. C. May 1, 1969

This plat is strictly conformable to the approved field notes, and the survey, having been correctly executed in accordance with the requirements of law and the regulations of this Bureau, is hereby accepted.

For the Director

Clark L. Gumm

Chief, Division of Cadastral Survey

Timber in this area consists of fir, madrone, dogwood, chinquapin, yew, maple, and cedar.

8 m K