TOWNSHIP 30 SOUTH, RANGE 3 WEST, OF THE WILLAMETTE MERIDIAN, OREGON

DEPENDENT RESURVEY AND SUBDIVISION OF SECTIONS

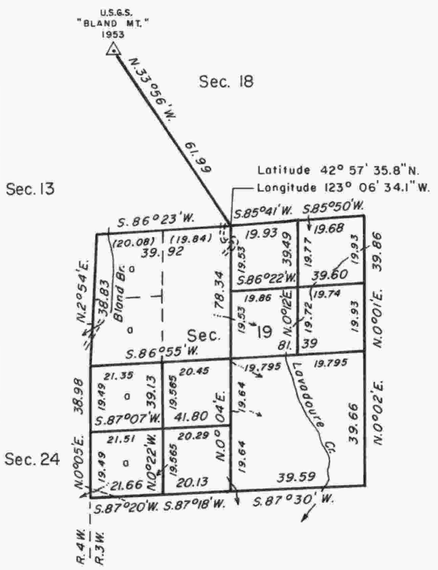

Mean magnetic declination

18°00' EAST

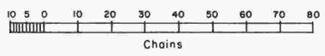

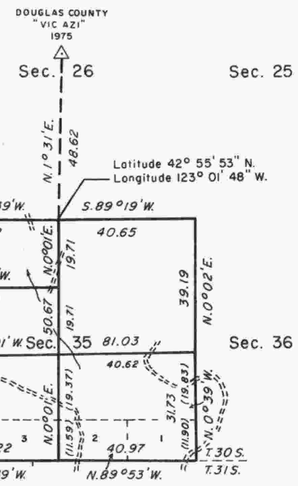

Sec. 3 Sec. 2

A history of surveys is contained in the field notes.

This plat represents a dependent resurvey of a portion of the south and west boundaries and subdivisional lines, T. 30 S., R. 3 W., Willamette Meridian, Oregon, designed to restore the corners in their true original locations according to the best available evidence, and the subdivision of sections 19 and 35.

The lottings and areas are as shown on the plats approved February 20, 1858, and June 29, 1895.

The survey was executed by Wayne L. Rogers, Lance J. Bishop, and James L. White, Cadastral Surveyors, beginning June 7, 1983, and completed December 12, 1984, pursuant to Special Instructions dated December 21, 1982, under Group Number 1133, Oregon.

Timber in this area consists of fir, madrone, pine, alder, dogwood, ash, hemlock, willow, oak, cedar, yew, maple, and chinquapin.

UNITED STATES DEPARTMENT OF THE INTERIOR
BUREAU OF LAND MANAGEMENT
Portland, Oregon January 10, 1986

This plat is strictly conformable to the approved field notes, and the survey, having been correctly executed in accordance with the requirements of law and the regulations of this Bureau, is hereby accepted.

For the Director

William W. Glenn

Chief Cadastral Surveyor of Oregon

USA