TOWNSHIP 30 SOUTH, RANGE 3 WEST, OF THE WILLAMETTE MERIDIAN, OREGON

CORRECTIVE DEPENDENT RESURVEY

FILED
Date: 6/9/2010 By: JC
This survey consists of:
~~Map:~~
~~Narrative:~~ VOL 56
~~Corner Rpt.~~ PGS 22100-22106

DOUGLAS COUNTY SURVEYOR

OFFICIALLY FILED: 4/23/2010

A history of surveys is contained in the field notes.

This plat represents a corrective dependent resurvey of a portion of the subdivisional lines, T. 30 S., R. 3 W., Willamette Meridian, Oregon, designed to restore the corners in their true original locations according to the best available evidence.

The survey was performed utilizing both conventional (directly measured angles and distances) and NAVSTAR Global Positioning System (GPS) satellite techniques. The GPS measurements utilized dual frequency, carrier phase GPS receivers. The baselines were computed and adjusted by least squares analysis. Conventionally measured distances and directions have been adjusted by computer software that incorporates a least squares adjustment routine. The adjusted bearings and distances are reported to the nearest second and 0.01 foot.

The survey was executed by A. Bert Skeesick, Cadastral Surveyor, beginning March 13, 2006, and completed April 20, 2006, pursuant to Special Instructions dated February 3, 2006, under Group Number 2134, Oregon.

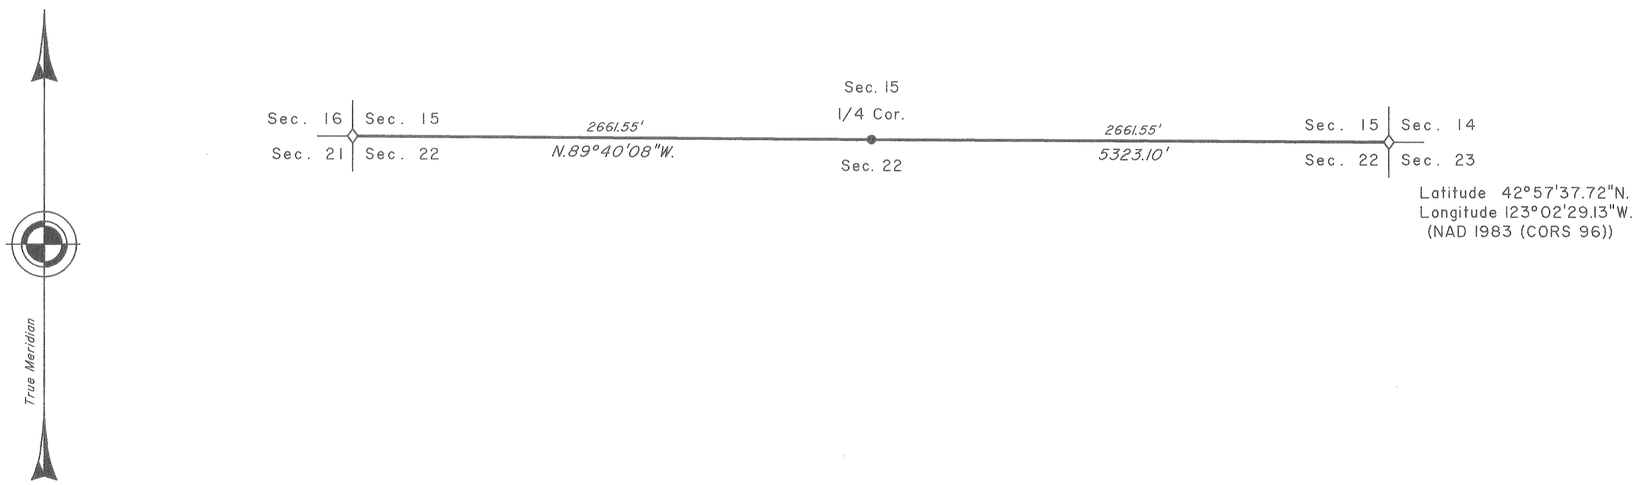

LEGEND

◇ Original corner previously remonumented

● Corner reestablished this survey

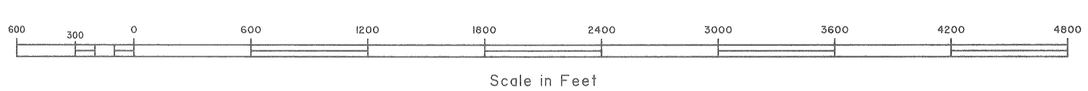

UNITED STATES DEPARTMENT OF THE INTERIOR
BUREAU OF LAND MANAGEMENT

Portland, Oregon

This plat is strictly conformable to the approved field notes, and the survey, having been correctly executed in accordance with the requirements of law and the regulations of this Bureau, is hereby accepted.

For the Director

Mary J. M. Hunter

Chief Cadastral Surveyor of Oregon

April 5, 2010

Date

D.C.W.