Township No. 30 South Range No. 4 West of the Willamette Meridian Oregon

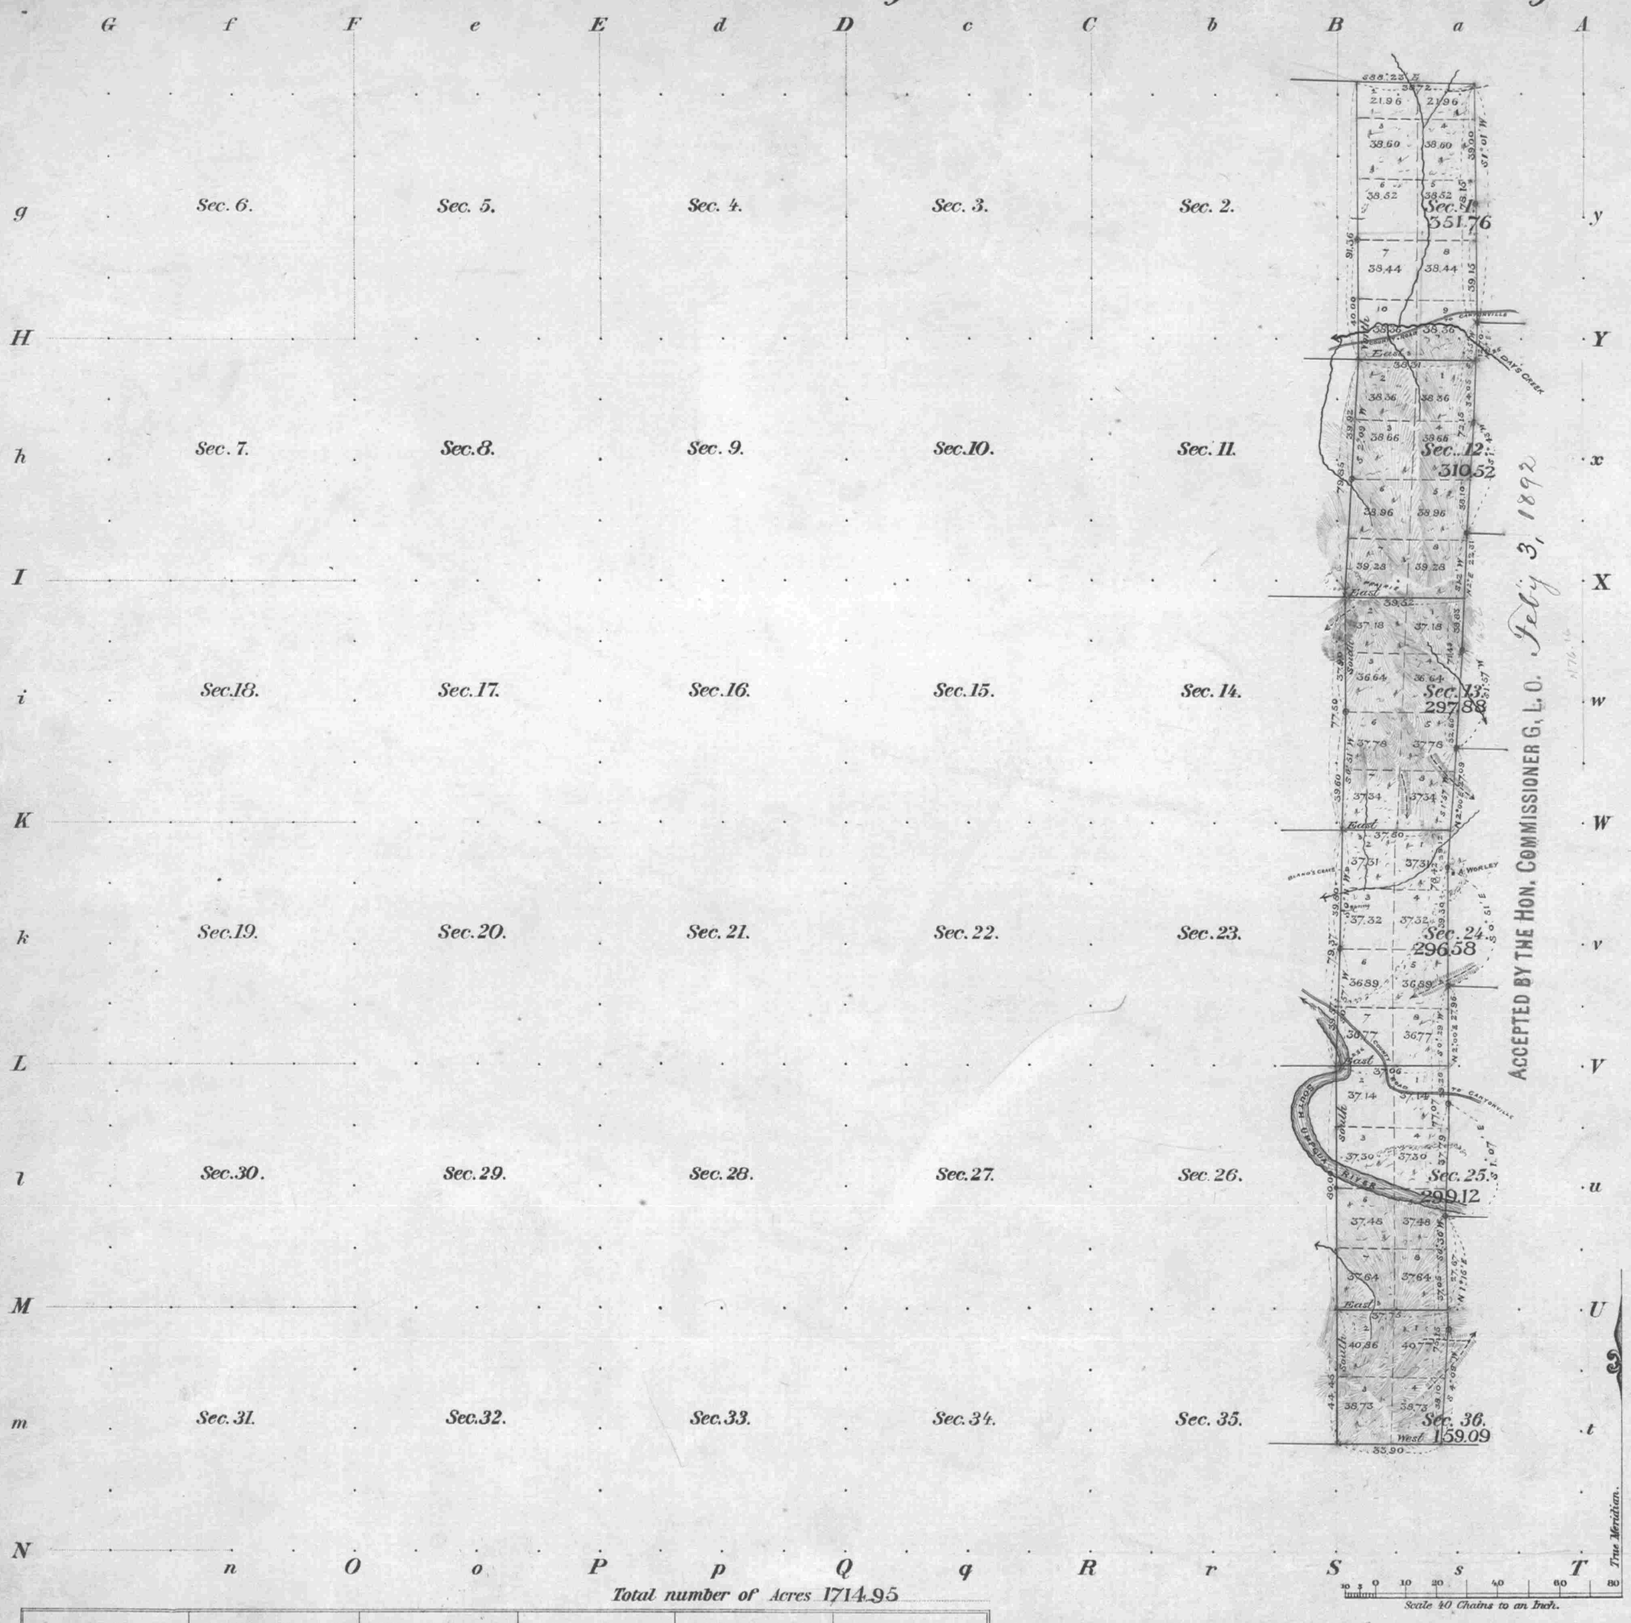

Meanders of

Posts	Courses	Ch.s Lk.s	Posts	Courses	Ch.s Lk.s	Posts	Courses	Ch.s Lk.s

Total number of Acres 1714.95

Surveys Designated	By Whom Surveyed	Date of Contract	Amount of Surveys M.	Ch.s	Lk.s	When Surveyed	Mean Declination
Township lines							
Subdivisions	W. F. Briggs	August 7th 1891	2	30	14	September 15 to 17 1891	19° 00' E
Connections	" " "	" " "	1	37	73	" " "	
Special Instructions							

The above Map of Township No. 30 South, of Range No. 4 West of the Willamette Meridian, Oregon, is strictly conformable to the field notes of the survey thereof on file in this Office, which have been examined and approved.

Surveyor General's Office,
Portland, Oregon Jan'y 21, 1892

W. Henry Byars
Sur.r Gen.l for Oregon