687

Township No. 30 South Range No. 5 West of the Willamette Meridian Oregon

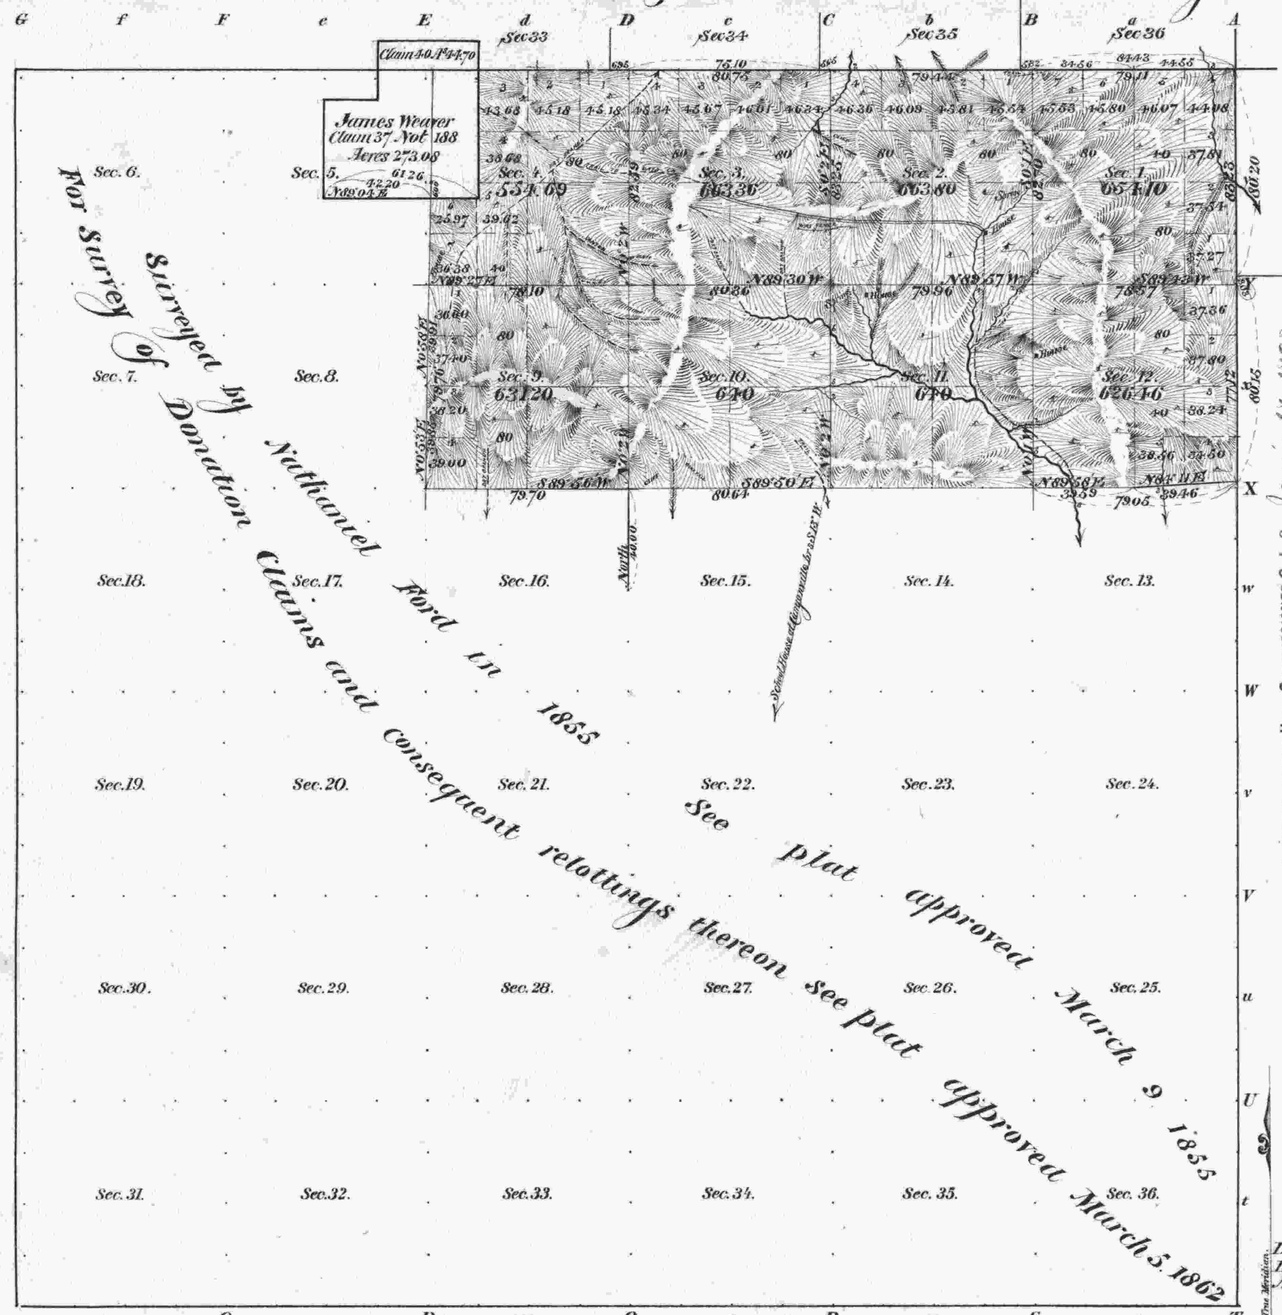

Meanders of

Posts	Courses	Ch.Lk.	Posts	Courses	Ch.Lk.	Posts	Courses	Ch.Lk.

ACCEPTED BY THE HON. COMMISSIONER G. L. O. Jany 12. 1898

True Meridian.

Latitude 42° 58' N
Longitude 123° 14' W
Mean mag dec. 20° 20' E
At camp near the middle of Sec 14

Area of Former Survey 18.051.06 Acres — of New Survey 5073.61 Acres Total number of Acres 23.124.67

Surveys Designated	By Whom Surveyed	Date of Contract		Amount of Surveys M.	Ch.s	Lk.s	When Surveyed	No. of Contract
Township lines								
Subdivisions	Oscar F. Thiel	May 21	1896	10	05	53	July 17 to 29. 1896	658
Corrections	" " "	" " "			20	95		"
Between of North B'dy of Sec 1 2 3 4 — S B'dy of Sec 4 10 11 12 and West B'dy of Secs 4 and 8	" " "	" " "		8	77	27		"
East B'dy of Sec 1 12 13 24 25 and 36	J. M. Freeman	May 28	1851				1851	1
N. S. and W. lines of T. 29	Walter Lyons	January 4	1854				1854	39
Meanders of S. B'dy of Secs 5 6 7 8	Nathaniel Ford	May 30	1854				1855	49
" East B'dy of T. 29	Wm. H. Byars	July 28	1852				1852	456
	Wm. Thiel	Feb 5	1859				1859	555

The above Map of Township No. 30 South of Range No. 5 West of the Willamette Meridian, Oregon is strictly conformable to the field notes of the survey thereof on file in this Office, which have been examined and approved.

Surveyor General's Office,
Portland Oregon Nov 6 1897

Robert A. Habersham
Sur. Gen. for Oregon