TOWNSHIP 30 SOUTH, RANGE 5 WEST, OF THE WILLAMETTE MERIDIAN, OREGON

SHEET 1 OF 2

DEPENDENT RESURVEY AND SUBDIVISION OF SECTIONS

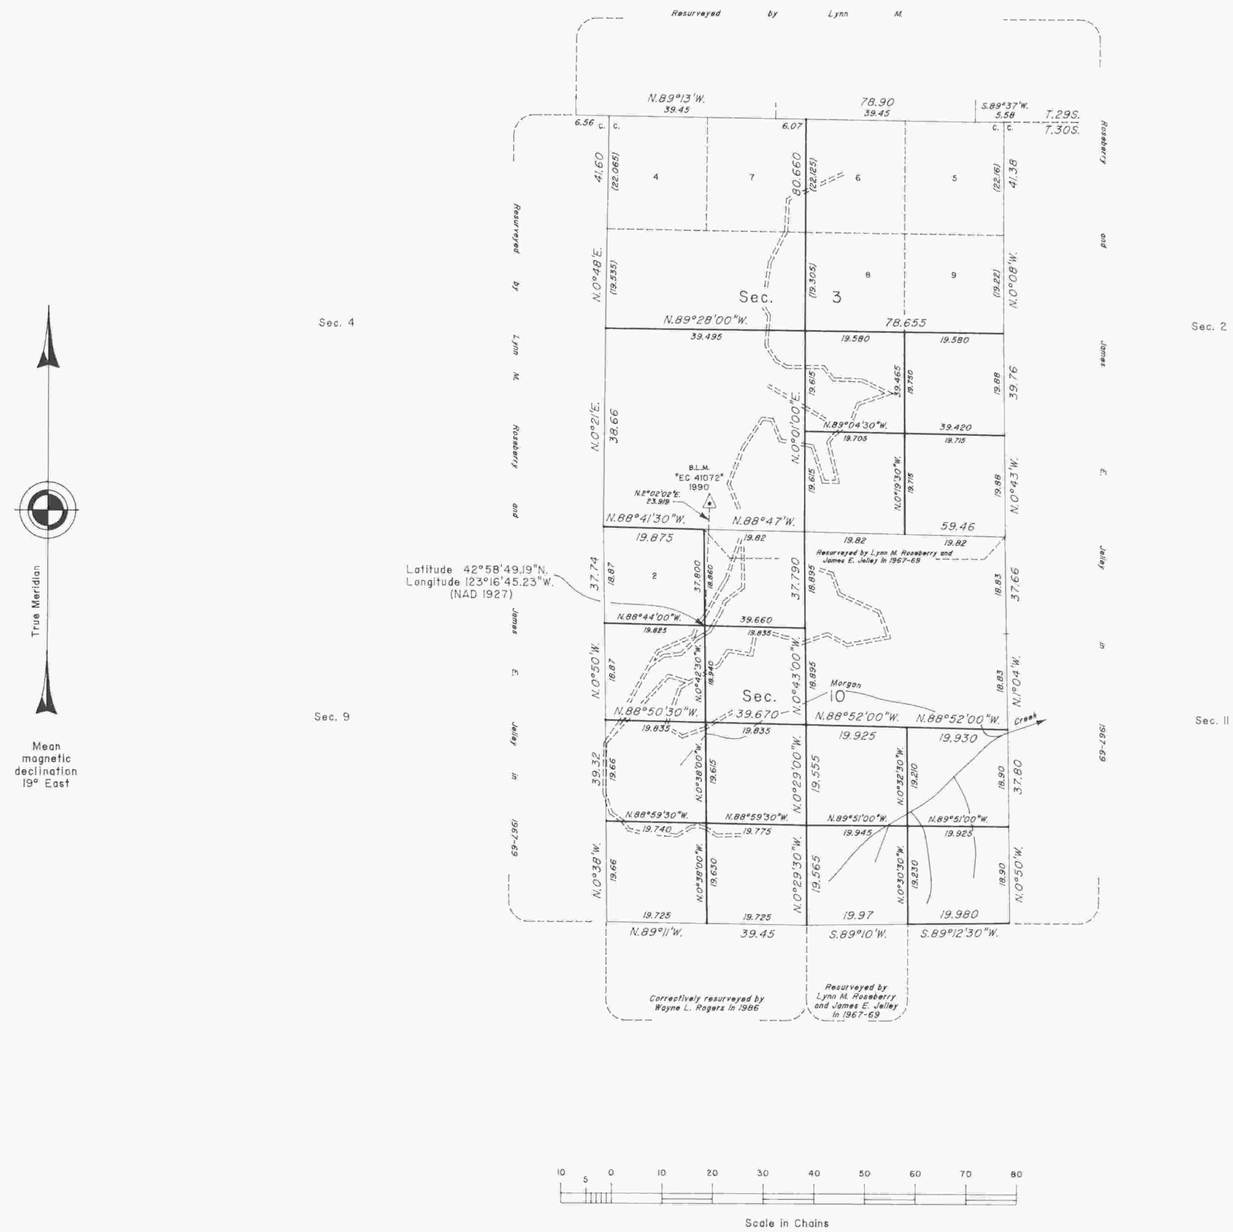

A history of surveys is contained in the field notes.

Theses plats represent a dependent resurvey of a portion of the subdivisional lines, and the subdivision of sections 3, 10 and 15, T. 30 S., R. 5 W., Willamette Meridian, Oregon.

The lottings and areas are as shown on the plats approved March 9, 1855, March 5, 1862, and November 6, 1897, and the plats accepted May 31, 1978 and March 3, 1989.

The survey was executed by Wayne L. Rogers, Cadastral Surveyor, beginning August 28, 1990, and completed July 11, 1991, pursuant to Special Instructions dated August 7, 1990, under Group Number 1565, Oregon.

Timber in this area consists of fir, pine, yew, alder, maple, oak, willow, cascara, ash, dogwood, madrone, chinquapin and cedar.

UNITED STATES DEPARTMENT OF THE INTERIOR
BUREAU OF LAND MANAGEMENT

Portland, Oregon — January 4, 1994

This plat is strictly conformable to the approved field notes, and the survey, having been correctly executed in accordance with the requirements of law and the regulations of this Bureau, is hereby accepted.

For the Director

Wayne M. Gardner

Chief Cadastral Surveyor of Oregon

R.F.B.