6863

ORIGINAL

FILED

Date: 3-17-1999 By: JP

This survey consists of:

Map:

Narrative Vol 52 763

Corner Rpt: 19971 - 19988

DOUGLAS COUNTY SURVEYOR

TOWNSHIP 30 SOUTH, RANGE 5 WEST, OF THE WILLAMETTE MERIDIAN, OREGON

SURVEY OF TRACT 64

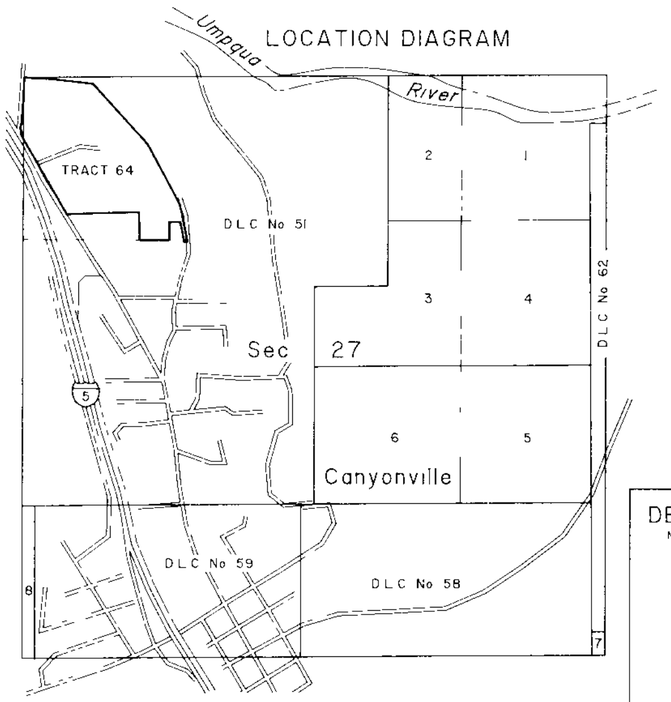

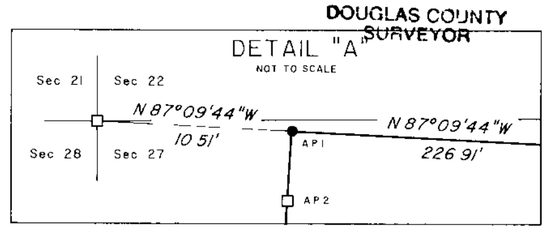

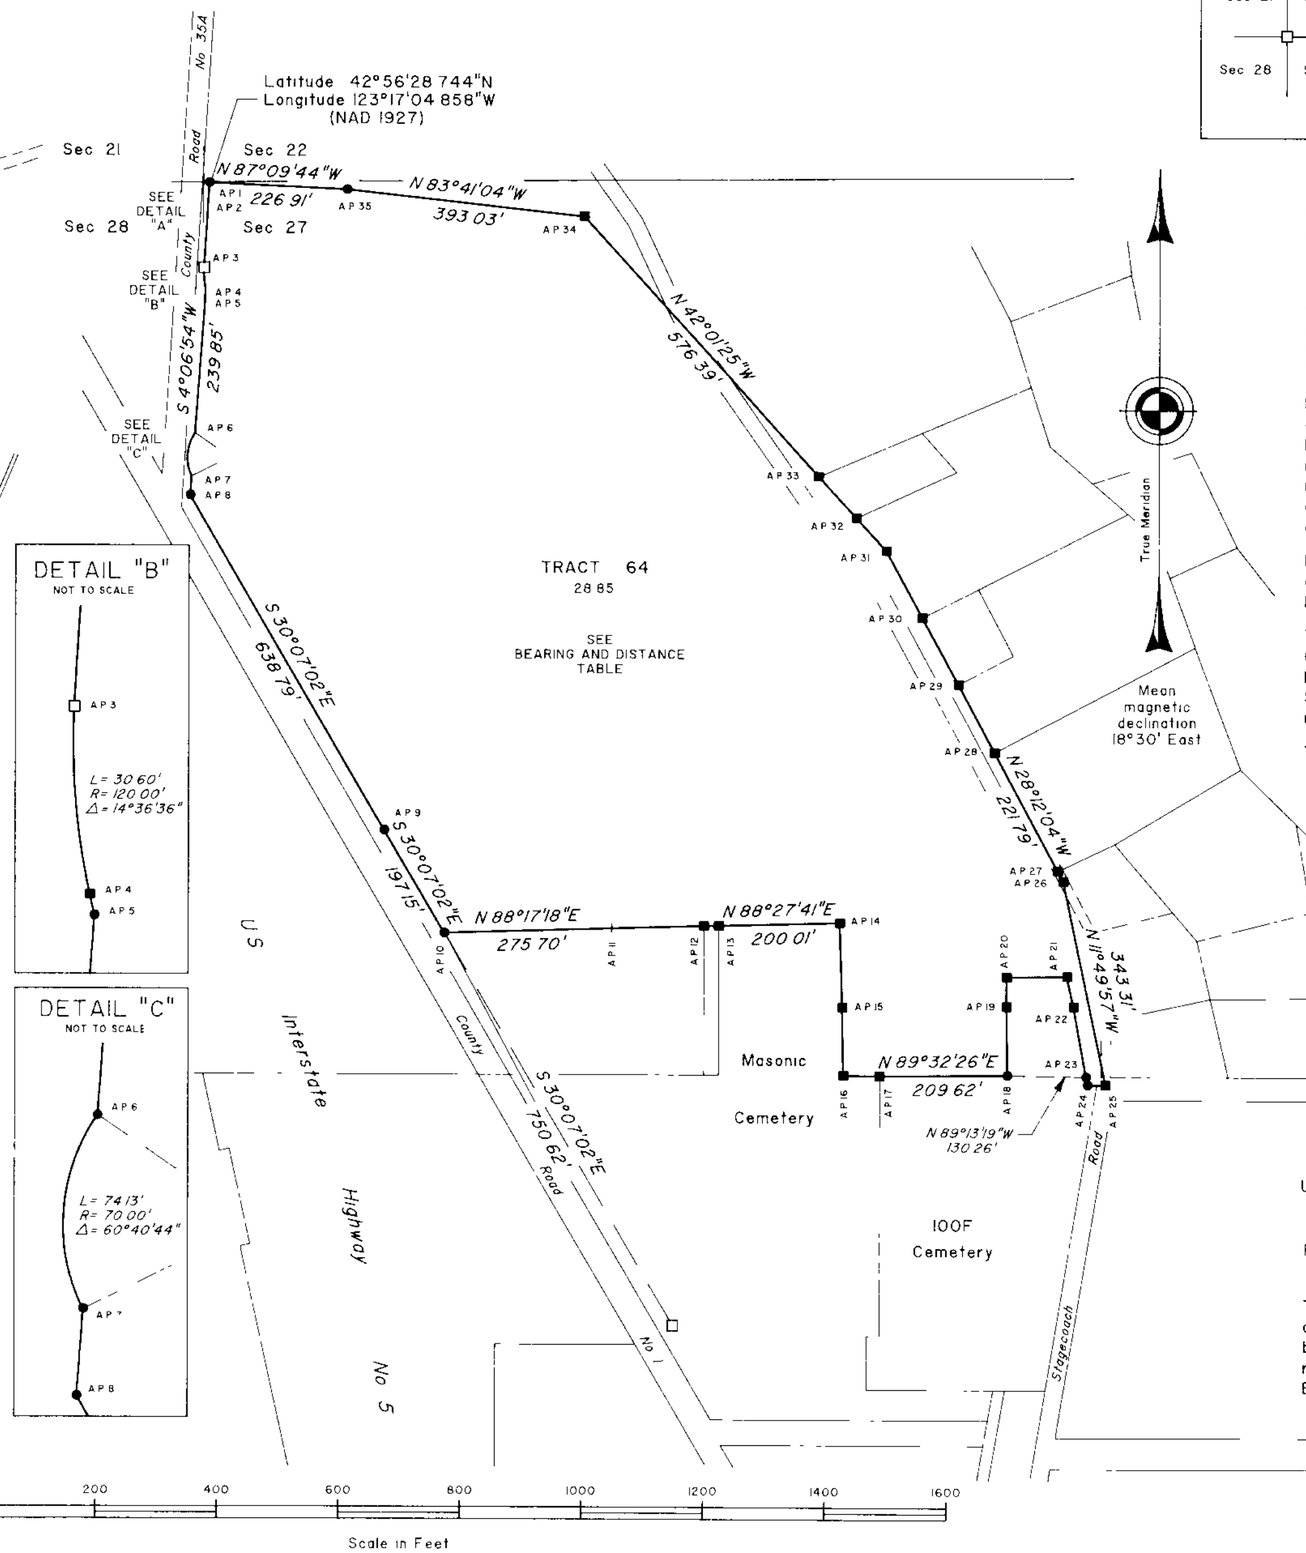

BEARING AND DISTANCE TABLE - TRACT 64

AP1			AP18		
	S 3°33'50"W	3 78'	AP19	N 0°42'16"W	113 04'
AP2	S 3°34'15"W	137 45'	AP20	N 0°08'05"E	49 05'
AP3			AP21	N 89°19'27"E	99 77'
R=120 00'	Δ=14°36'36"	L=30 60'	AP22	S 12°17'27"E	51 09'
AP4	S 12°07'12"E	3 42'	AP23	S 10°17'05"E	116 99'
AP5	S 4°06'54"W	239 85'	AP24	S 10°17'05"E	13 44'
AP6			AP25	S 89°13'19"E	29 57'
R=70 00'	Δ=60°40'44"	L=74 13'	AP26	N 11°49'57"W	343 31'
AP7	S 4°06'54"W	31 78'	AP27	N 28°03'51"W	19 86'
AP8	S 30°07'02"E	638 79'	AP28	N 28°12'04"W	221 79'
AP9	S 30°07'02"E	197 15'	AP29	N 28°05'07"W	127 00'
AP10	N 88°17'18"E	275 70'	AP30	N 28°17'52"W	124 89'
AP11	N 88°25'03"E	151 11'	AP31	N 28°12'39"W	125 37'
AP12	N 88°29'12"E	24 26'	AP32	N 41°57'47"W	73 41'
AP13	N 88°27'41"E	200 01'	AP33	N 42°18'04"W	92 62'
AP14	S 1°41'54"E	139 76'	AP34	N 42°01'25"W	576 39'
AP15	S 0°58'39"E	112 59'	AP35	N 83°41'04"W	393 03'
AP16	S 89°36'22"E	59 31'	AP1	N 87°09'44"W	226 91'
AP17	N 89°32'26"E	209 62'			

A history of surveys is contained in the field notes

This plat represents a metes-and-bounds survey of Tract 64, T 30 S., R 5 W., Willamette Meridian, Oregon, designed to restore the corners in their true original locations according to the best available evidence

Measured distances and directions have been adjusted by Cadastral Measurement Management (CMM), a computer program that incorporates a least squares adjustment routine The adjusted bearings and distances are reported to the nearest second and 0 01 of a foot

Except as shown hereon, the lottings and areas are as shown on the plat approved March 9, 1855 and March 5, 1862

The survey was executed by Wayne L. Rogers, Cadastral Surveyor, beginning October 20, 1997, and completed July 27, 1998, pursuant to Special Instructions dated September 16, 1997, under Group Number 1866, Oregon

There is no timber

LEGEND

- Corner previously established or reestablished
- Corner previously established or reestablished remonumented this survey
- Corner established or reestablished this survey

200 100 0 200 400 600 800 1000 1200 1400 1600

Scale in Feet

UNITED STATES DEPARTMENT OF THE INTERIOR
BUREAU OF LAND MANAGEMENT

Portland, Oregon December 4, 1998

This plat is strictly conformable to the approved field notes, and the survey, having been correctly executed in accordance with the requirements of law and the regulations of this Bureau, is hereby accepted

For the Director

Wayne L. Gardner

Chief Cadastral Surveyor of Oregon

R F B