ORIGINAL

TOWNSHIP 30 SOUTH, RANGE 5 WEST, OF THE WILLAMETTE MERIDIAN, OREGON

RETRACEMENT

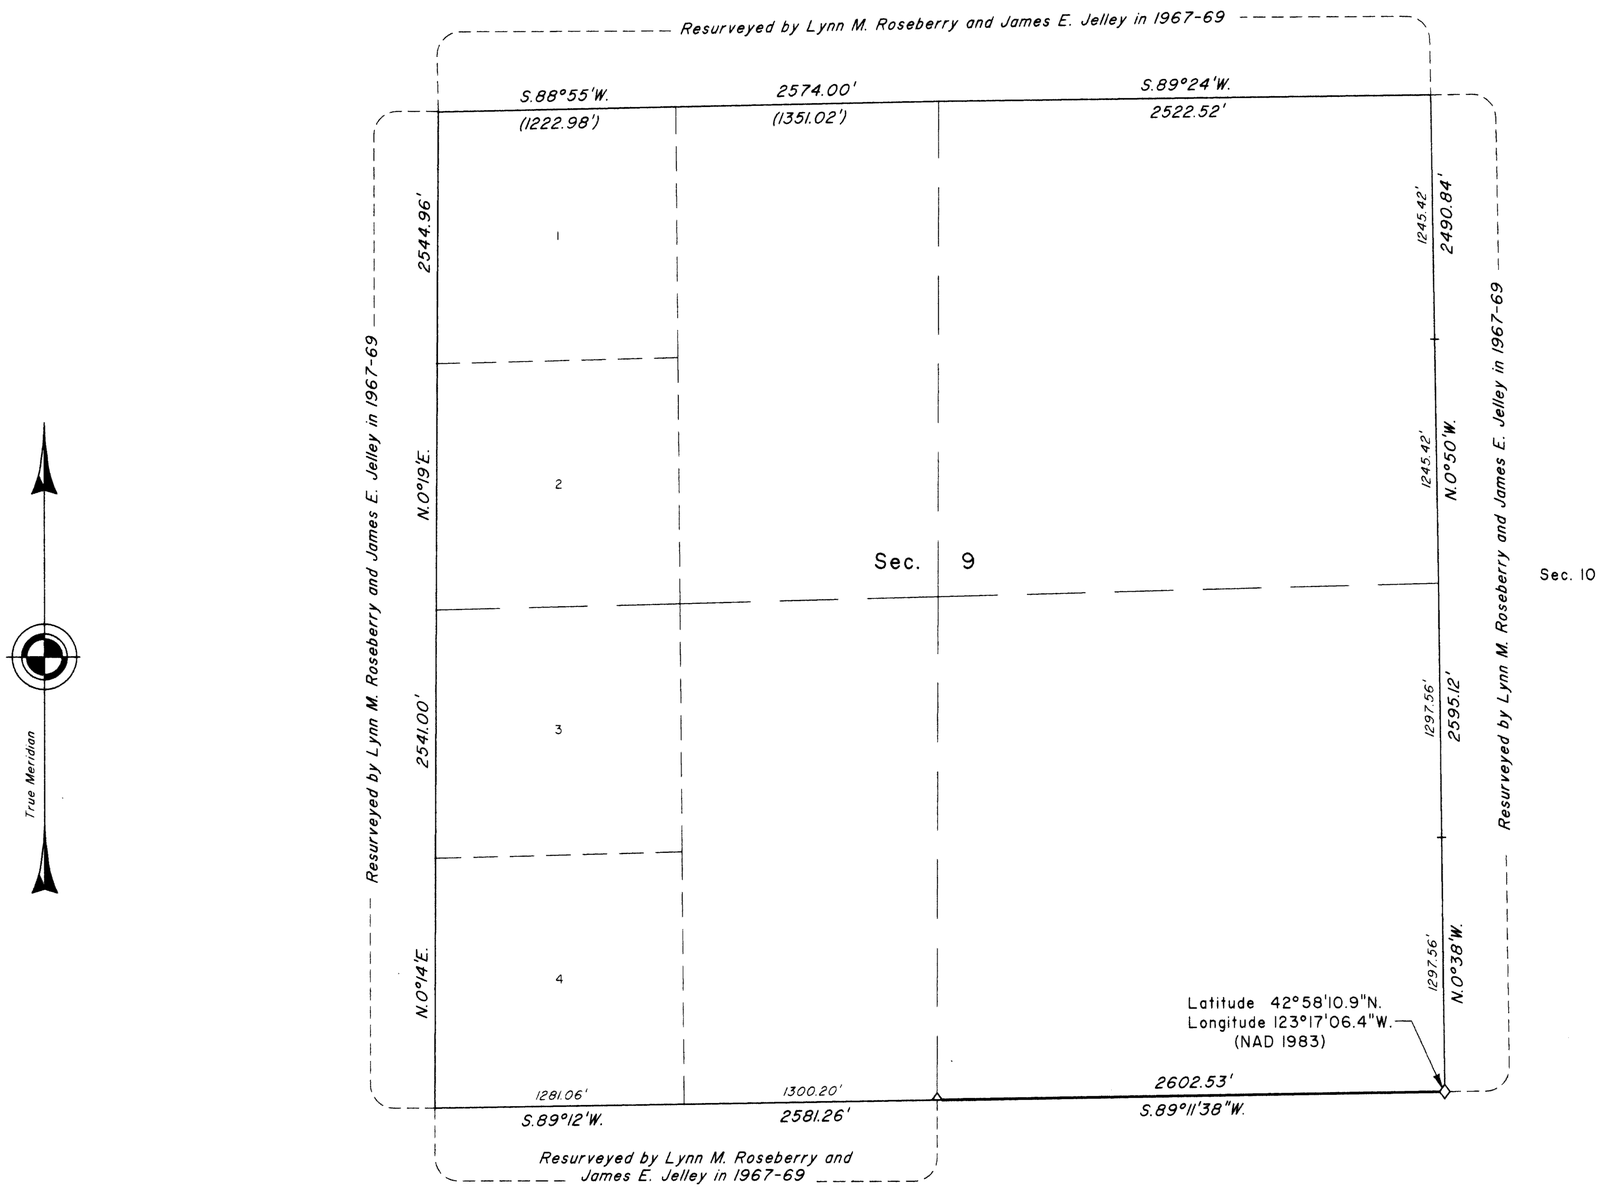

This plat represents the entire survey record of the retracement of a portion of the subdivisional lines, T. 30 S., R. 5 W., Willamette Meridian, Oregon.

The history of the surveys pertaining to this retracement is as follows:

In 1855, Nathaniel Ford, U.S. Deputy Surveyor, surveyed a portion of the subdivisional lines.

In 1896, Oscar F. Thiel, U.S. Deputy Survey, surveyed the remainder of the subdivisional lines.

In 1967-69, Lynn M. Roseberry and James E. Jelley, Cadastral Surveyors, resurveyed a portion of the subdivisional lines.

In 1986, Wayne L. Rogers, Cadastral Surveyor, performed a corrective resurvey of a portion of the subdivisional lines.

The direction of the lines were determined by direct solar observations, carried forward by sustained angulation, and refers to the true meridian.

Measured distances and directions have been adjusted by computer software that incorporates a least squares adjustment routine. The adjusted bearing and distance is reported to the nearest second and 0.01 foot.

The lottings and areas are as shown on the plat approved November 6, 1897.

The retracement was executed by A. Bert Skeesick, Cadastral Surveyor, and Robert H. Browning, Surveying Technician, beginning August 11, 2004, completed August 24, 2004, pursuant to Special Instructions dated March 8, 2004, under Group Number 2100, Oregon and Assignment Instructions dated August 9, 2004. Unless otherwise noted the descriptions are as reported in the official record.

The geodetic position shown hereon was determined by Global Positioning Satellite (GPS) techniques, utilizing differentially corrected C/A code GPS receivers relative to the North American Datum 1983.

LEGEND

◇ Original corner previously remonumented in 1969

We, A. Bert Skeesick, Cadastral Surveyor, and Robert H. Browning, Surveying Technician, HEREBY CERTIFY upon honor, that in pursuance of special instructions bearing date of the 8th day of March, 2004, we have retraced a portion of the subdivisional lines, township 30 south, range 5 west, of the Willamette Meridian, in the State of Oregon. Said retracement has been executed in strict conformity with said special instructions, the Manual of Instructions for the Survey of the Public Lands of the United States, and in a manner described on this plat.

Cadastral Surveyor — January 10, 2007 Date

Surveying Technician — January 10, 2007 Date

UNITED STATES DEPARTMENT OF THE INTERIOR
BUREAU OF LAND MANAGEMENT

Portland, Oregon

The retracement represented by this plat, having been correctly executed in accordance with the requirements of law and the regulations of this Bureau, is hereby accepted.

For the Director

Mary J. M. Hautl

Chief Cadastral Surveyor of Oregon

January 26, 2007
Date

600 300 0 600 1200 1800 2400 3000 3600 4200 4800

Scale in Feet

RHL