TOWNSHIP No. 30 SOUTH, RANGE No. 9 WEST, OF THE WILLAMETTE MERIDIAN, OREGON.

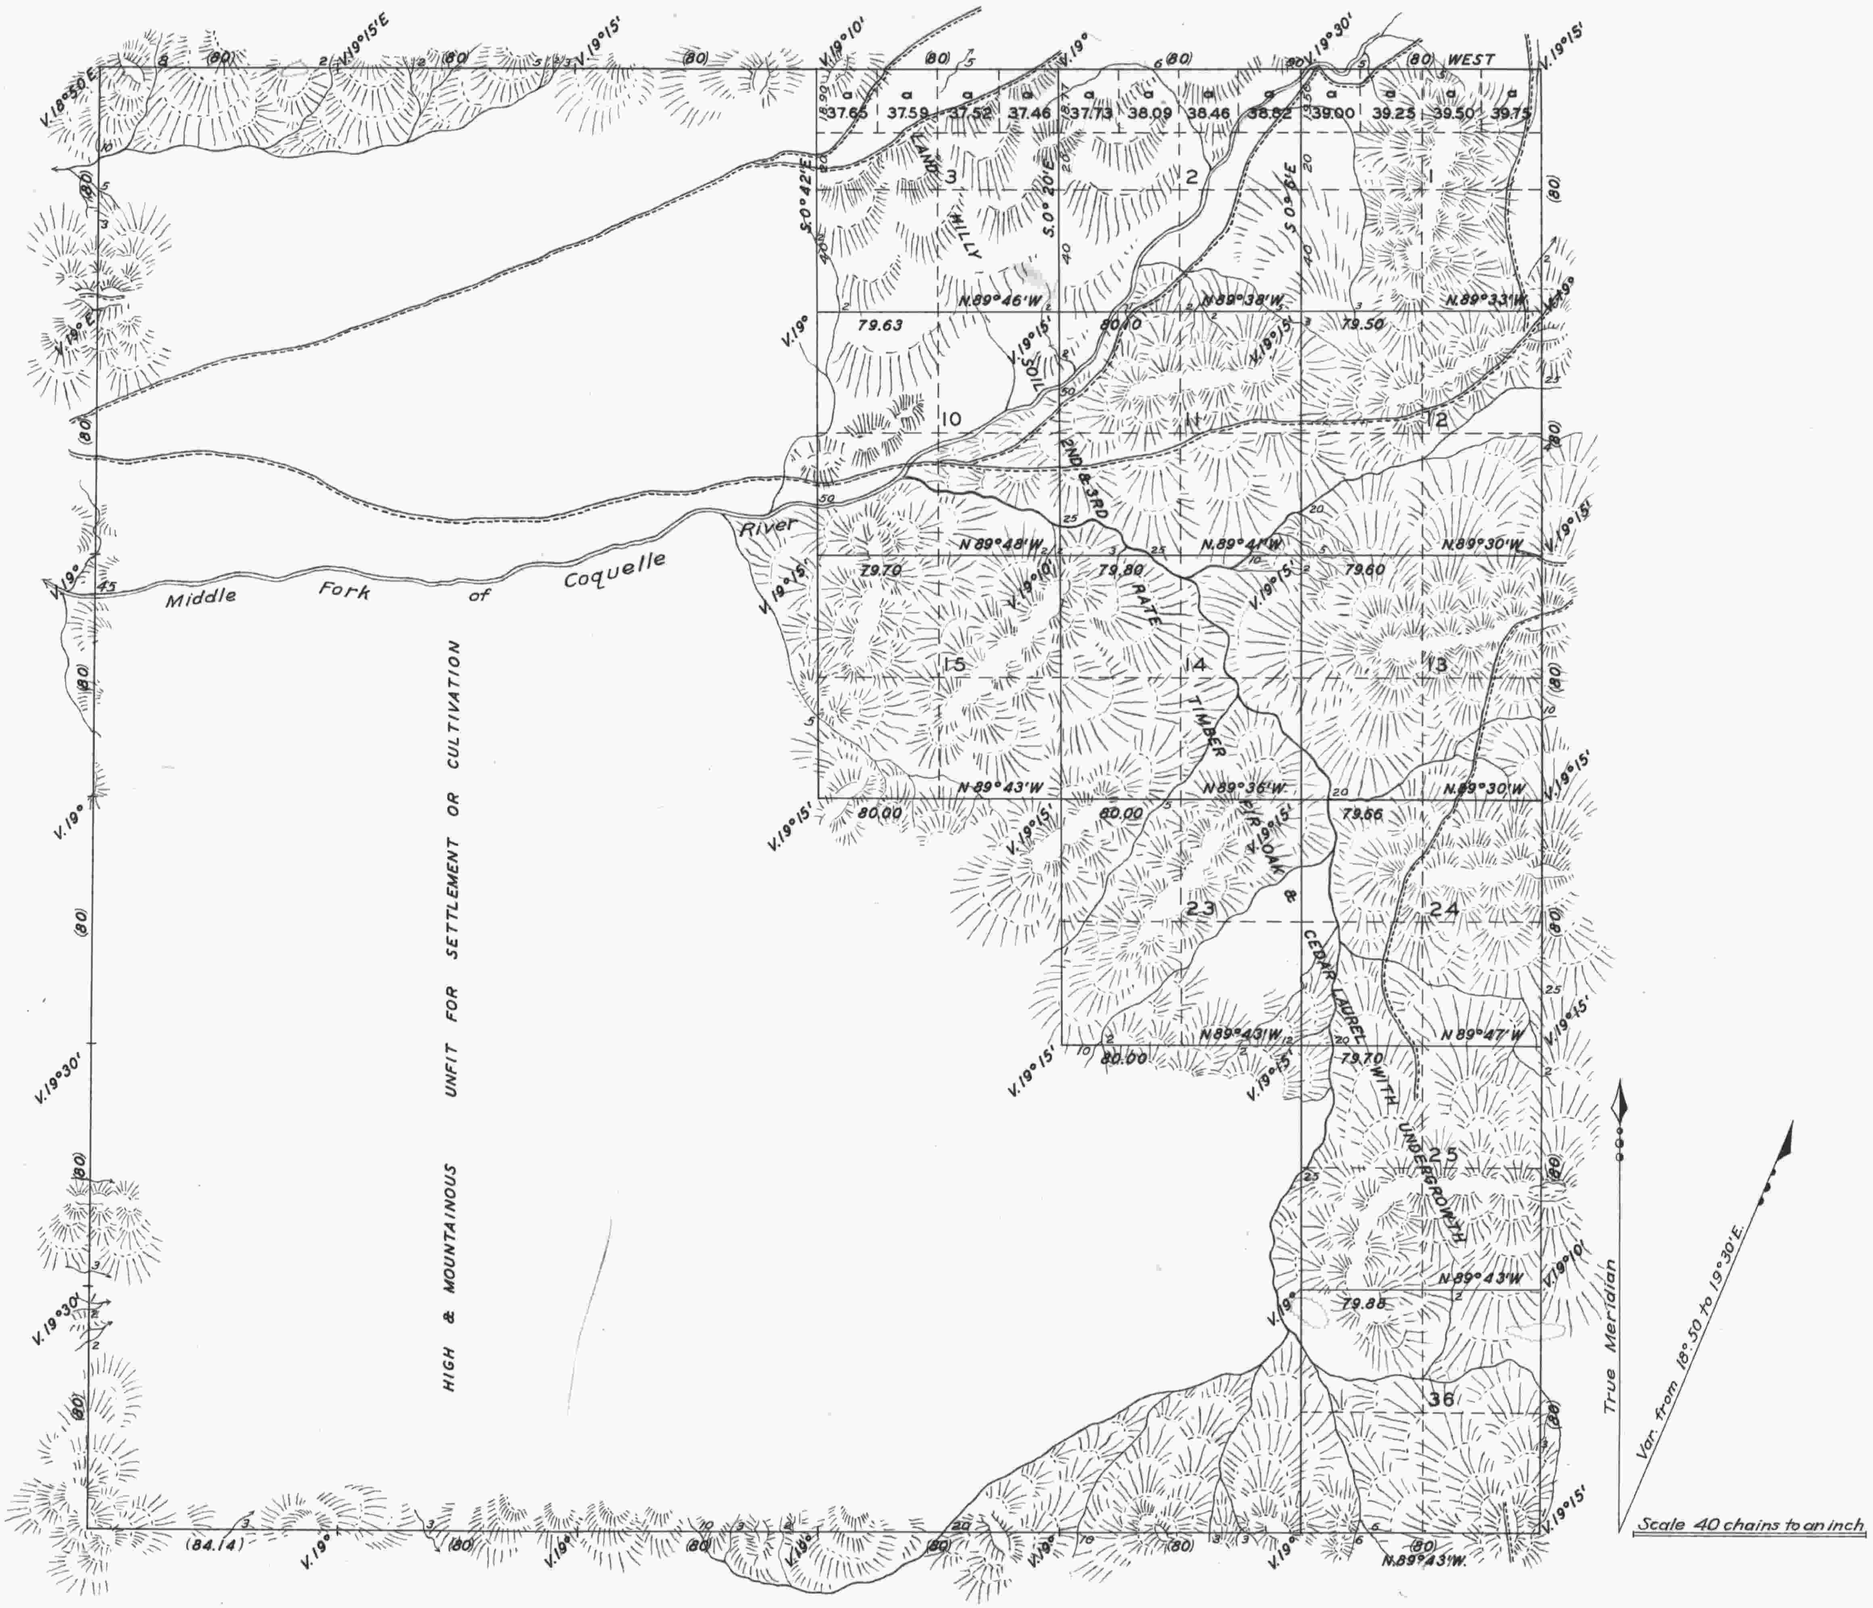

SURVEYS DESIGNATED	BY WHOM SURVEYED	CONTRACT		AMT. OF SURVEYS			WHEN SURVEYED
		No.	DATE	MILES	CHAINS	LINKS	
Township Lines	Dennis Hathorn	57	April 12th 1855	18	04	14	July 7th 1856
Subdivisions	Dennis Hathorn	57	April 12th 1855	24	74	74	July 7th 1856
Total number of Acres 8300..82							

The above Map of Fractional Township No. 30 South of Range No. 9 West of the Willamette Meridian, Territory of Oregon is strictly conformable to the field notes of the survey thereof on file in this office, which have been examined and approved.
Surveyor General's Office.
Salem July 7th 1856.
(signed)
John S. Zieber.
Sur. Gen. of Oregon.

Public Survey Office,
Portland, Oregon.
October 9, 1946.
I certify this to be a correct copy of the original plat on file in this office.
Joseph A. Sanong
Regional Cadastral Engineer.

B.L.F. Copy