1279

Township No. 30 South Range No. 9 West of the Willamette Meridian Oregon

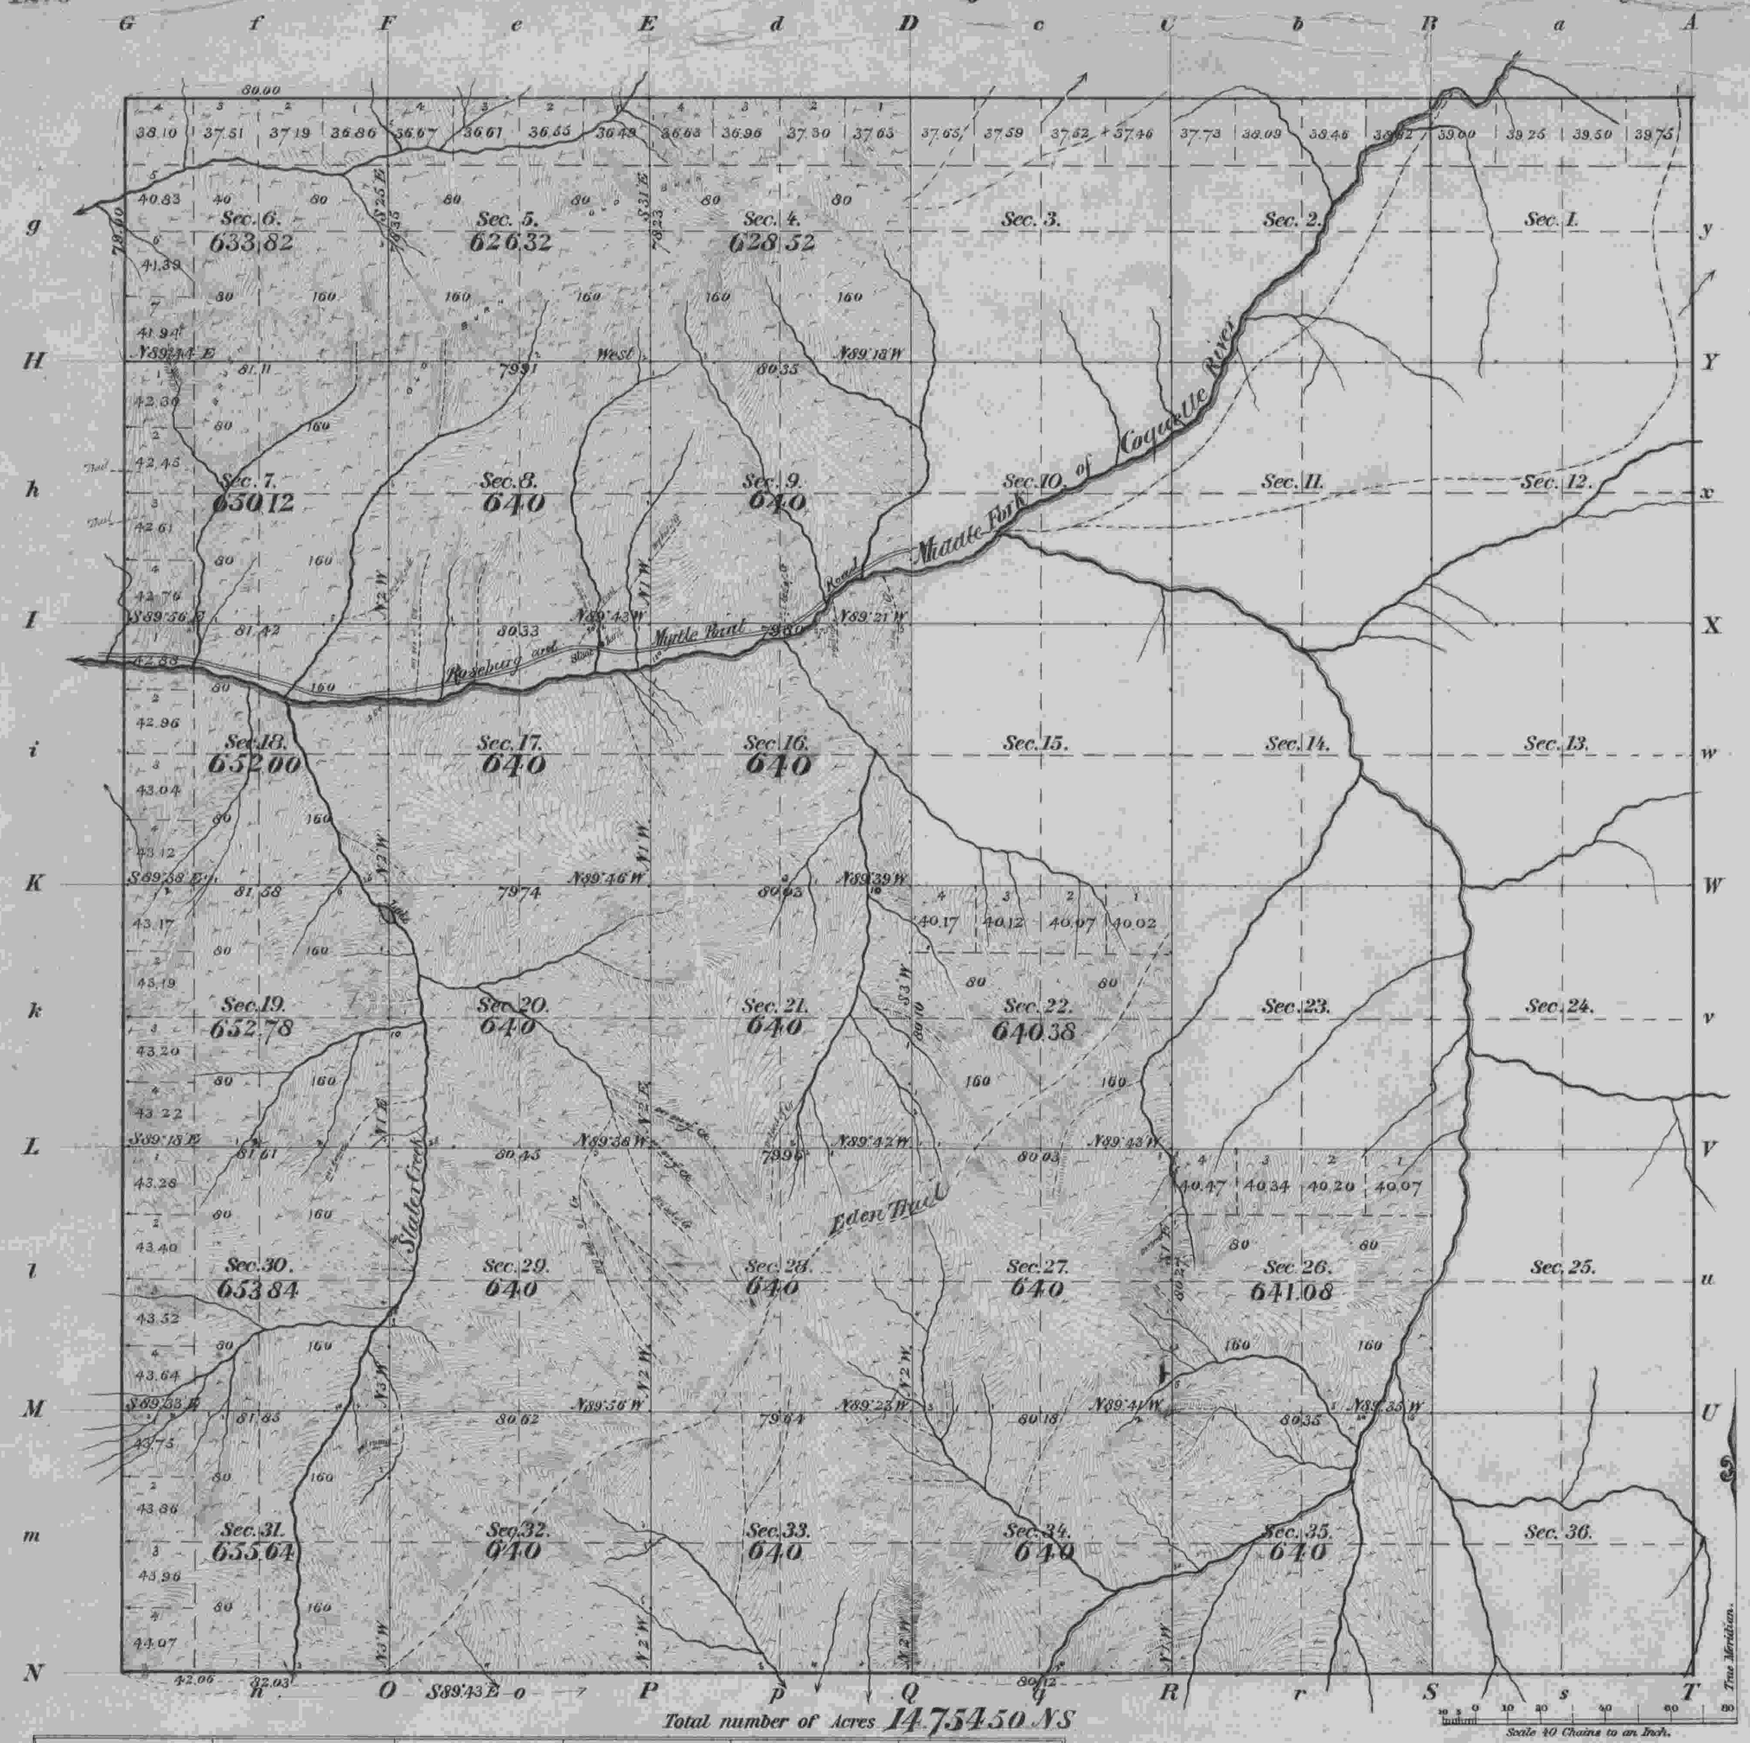

Total number of Acres 14,754.50 NS

Surveys Designated	By Whom Surveyed	Date of Contract	Amount of Surveys M. Ch.s Lk.s	When Surveyed	Mean Declination
Resurvey of Township lines	William M. Buskey	April 29. 1893	4. 02 15		
Subdivisions	William M. Buskey	April 29. 1893	35. 05 91	August 16th Sept 4 1893	19° 07' 30" E.
Contract No 613					

Meanders of								
Posts	Courses	Ch.s Lk.s	Posts	Courses	Ch.s Lk.s	Posts	Courses	Ch.s Lk.s

The above Map of Township No. 30 South of Range No. 9 West of the Willamette Meridian, Oregon, is strictly conformable to the field notes of the survey thereof on file in this Office, which have been examined and approved.

Surveyor Generals Office,
Portland Oregon June 26, 1894

W. Henry Byars
Sur.r Gen.l for Oregon