Township No. 31 South Range No. 2 West of the Willamette Meridian Oregon

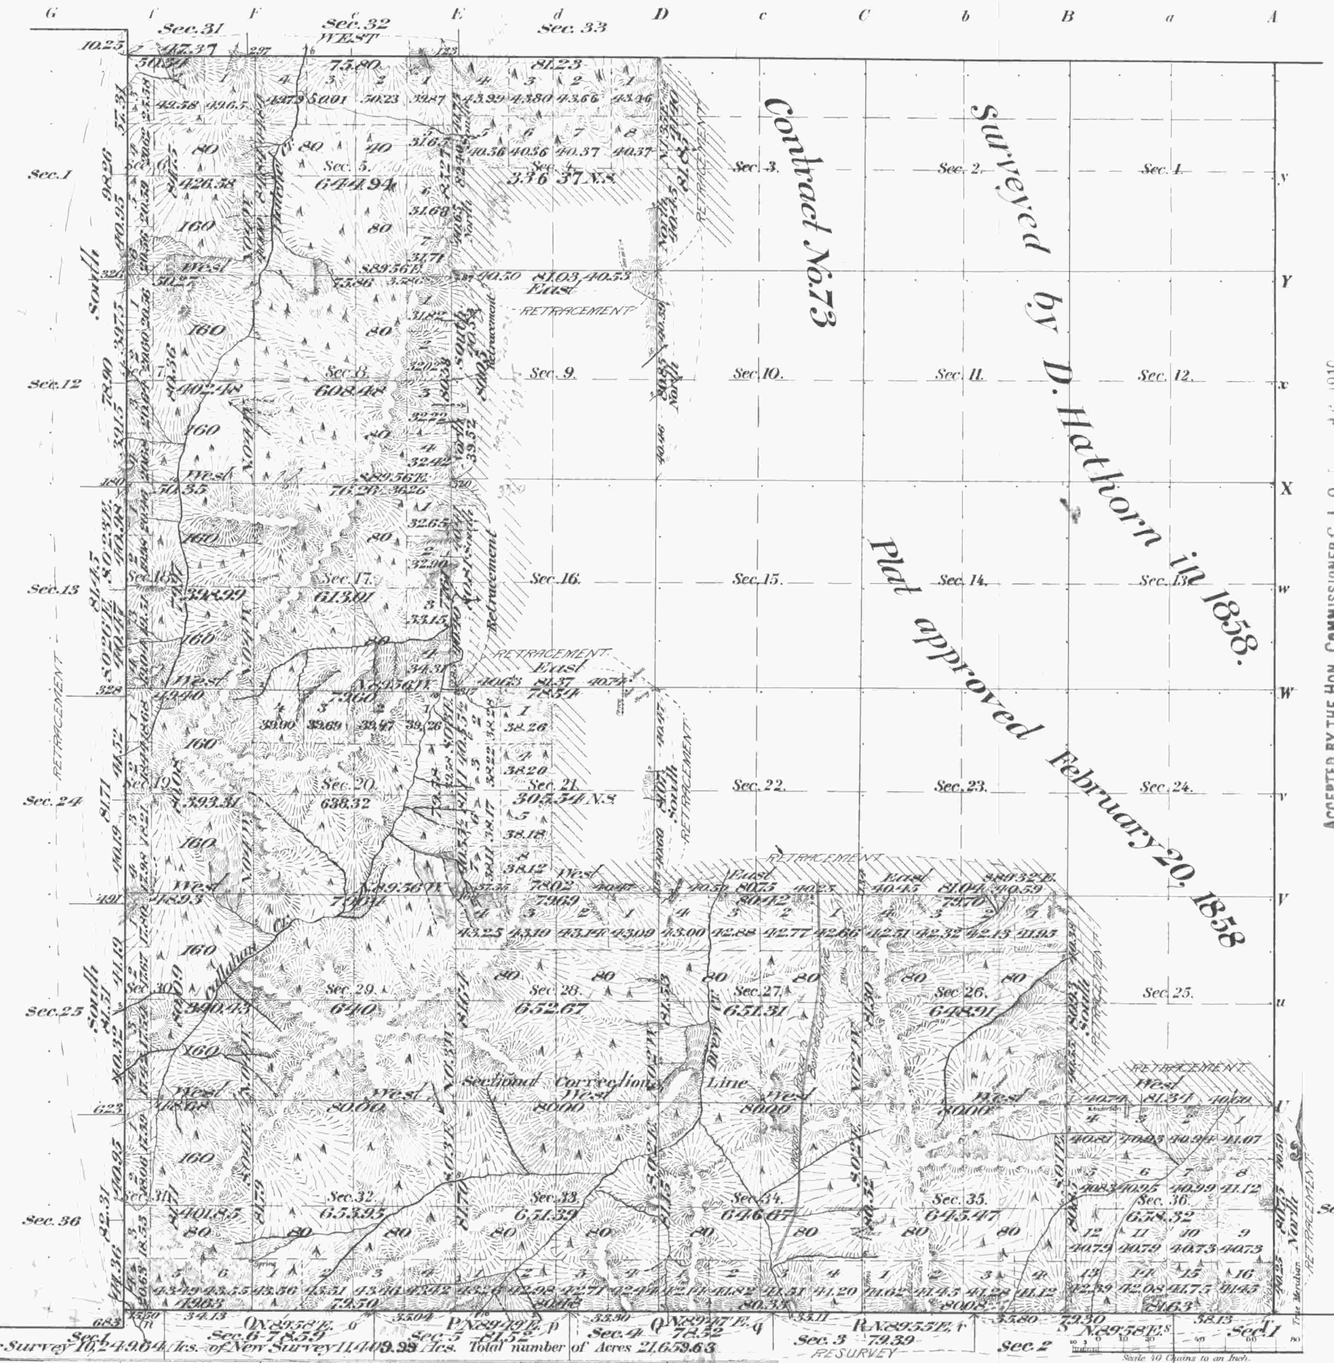

Area of Former Survey 10,249.64 Acs. of New Survey 11,409.99 Acs. Total number of Acres 21,659.63

Latitude 42°52' N. Longitude 122°53' W. Mean Mag. Decl. 21° E. } Near Cor. of Sec's. 25, 26, 35 and 36.

Surveys Designated	By Whom Surveyed	Date of Contract	Amount of Surveys M	Ch's	Lk's	When Surveyed	No. of Contract
Township lines N. Bdy. of Sec's. 31 & 6	Fred Mensch	May 10. 1906					766
Subdivisions	" " "	" " "	26	54	67	Oct. 23. 1906 to July 4. 1908	766
Connections	" " "	" " "	2	54	81		"
Retracements of Subd'ns	" "	" " "	11	52	69	Oct. 29. 1906 to June 30. 1908	"
" " of W. Bdy.	" "	" " "	7	24	88	Oct. 20. 1906 to July 12. 1908	"
Of Tp. and E. Bdy. of Sec. 36							
Resurvey of S. Bdy. of Tp.			5	51	65		"
S. Bdy. of Tp. (original)	Charles L. Campbell	" 5 1902				1902	747
W. " "	Wm. M. Bushey	June 17. 1893				1893	626
E. Bdy. of Tp. and N. Bdy. of Sec's. 1, 2, 3 & 4	Dennis Hathorn	" 8 1857				1857	73

The above Map of Township No. 31 South, of Range No. 2 West of the Willamette Meridian, Oregon, is strictly conformable to the field notes of the survey thereof on file in this Office, which have been examined and approved.

Surveyor General's Office,
Portland, Oregon June 18, 1909.

George Vergnette
Sur. Gen'l for Oregon.

ACCEPTED BY THE HON. COMMISSIONER G. L. O. 28 1910

Meanders of

Posts	Courses	Ch's Lk's	Posts	Courses	Ch's Lk's	Posts	Courses	Ch's Lk's

The above Map of Tp. 31 S., R. 2 W. has been amended to conform to supplemental notes on file in this Office which have been examined and approved.
Sur. Gen'l's Office
Portland Oregon
Jan'y 18. 1910

George Vergnette
Sur. Gen'l for Oregon