# Township No. 31 South Range No. 2 East of the Willamette Meridian Oregon

1946

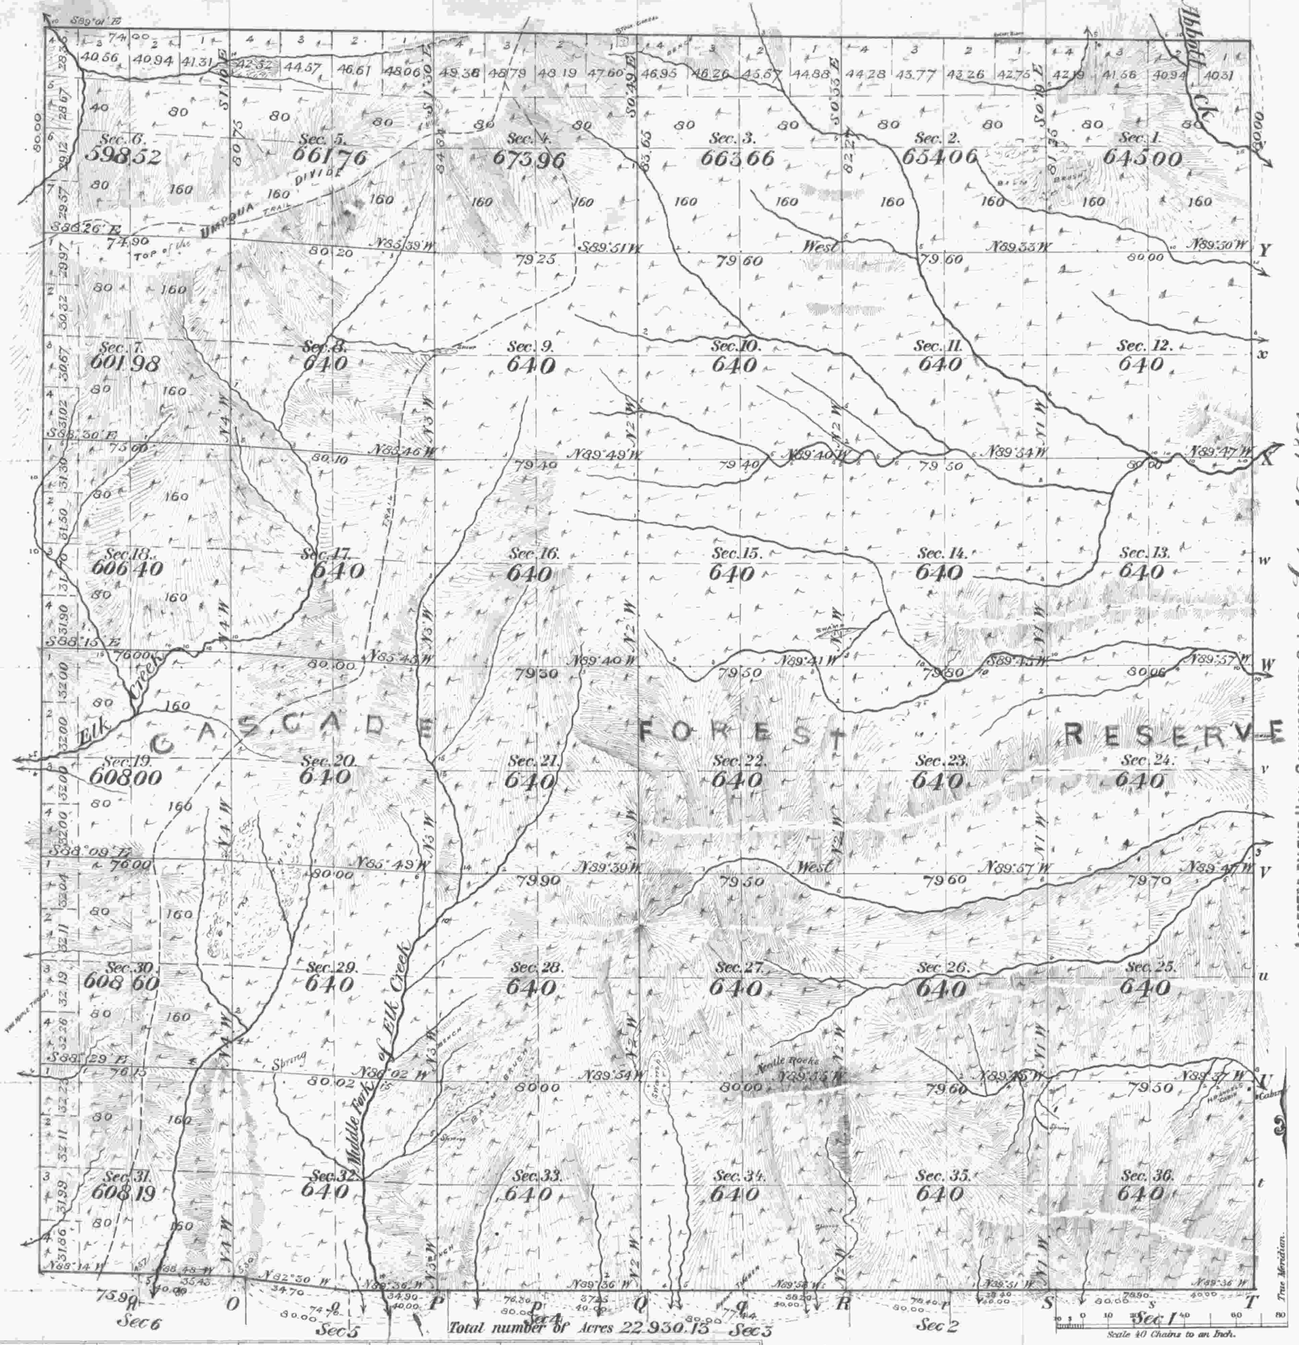


Total number of Acres 22,930.15

| Surveys Designated | By Whom Surveyed | Date of Contract | Amount of Surveys M. Ch.s Lk.s | When Surveyed | Mean Declination |
|---|---|---|---|---|---|
| Township lines | | | | | |
| Subdivisions | Peter Applegate | April 10 1891 | 59. 64. 94 | Sep.t 8 to Oct. 2. 1891 | 19°52'30" E. |
| Contract No 571 | | | | | |

The above Map of Township No. 31 South of Range No. 2 East Willamette Meridian Oregon is strictly conformable to the field notes of the survey thereof on file in this Office, which have been examined and approved.

Surveyor Generals Office, Portland Oregon Aug. 18, 1892

W. Henry Byars Sur.r Gen.l for Oregon

ACCEPTED BY THE HON. COMMISSIONER G. L. O. Sept. 15 1892

Meanders of

| Posts | Courses | Ch.s Lk.s | Posts | Courses | Ch.s Lk.s | Posts | Courses | Ch.s Lk.s |
|---|---|---|---|---|---|---|---|---|