ORIGINAL

TOWNSHIP 31 SOUTH, RANGE 4 WEST, OF THE WILLAMETTE MERIDIAN, OREGON

RETRACEMENT

DCSO NOTE:
CORNER NOTES FOR THE CORNERS
SHOWN ON THIS PLAT AND THE CORNERS:
1/4 CORNER 22|23
AND SEC CORNER 15|14 / 22|23
ARE IN VOL. 56 PGS 21972-6
OF DCSO BLM LINE NOTES

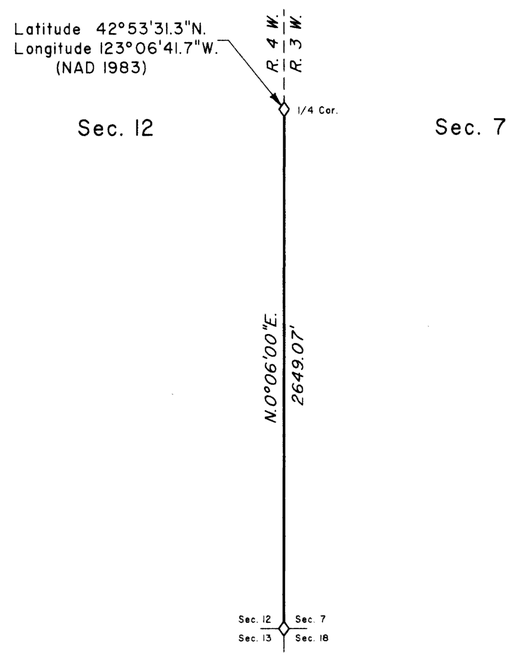

Mean magnetic declination 18°30' East

This plat represents the entire survey record of the retracement of a portion of the east boundary, T. 31 S., R. 4 W., Willamette Meridian, Oregon.

The history of surveys pertaining to this retracement is as follows:

In 1894, William M. Bushey, U. S. Deputy Surveyor, surveyed a portion of the east boundary and a portion of the subdivisional lines.

In 1894-86, Wayne L. Rogers, Rick A. McMullen, and Lance J. Bishop, Cadastral Surveyors, dependently resurveyed a portion of the north and east boundaries and subdivisional lines.

In 2004-2005, A. Bert Skeesick, Cadastral Surveyor and Robert H. Browning, Surveying Technician, executed concurrently under Group No. 2000, remonumented and rehabilitated certain corner points on the east boundary and subdivisional lines.

The direction of the line was determined by direct solar observations, carried forward by sustained angulation, and refer to the true meridian.

Measured distances and directions have been adjusted by computer software that incorporates a least squares adjustment routine. The adjusted bearing and distance is reported to the nearest second and 0.01 foot.

The retracement was executed by A. Bert Skeesick, Cadastral Surveyor, and Robert H. Browning, Surveying Technician, beginning December 6, 2004, and completed January 5, 2005, pursuant to Special Instructions dated March 8, 2004, under Group No. 2100, Oregon, and Assignment Instructions dated November 16, 2004.

The geodetic position shown hereon was determined by Global Positioning Satellite (GPS) techniques, utilizing differentially corrected code GPS receivers relative to the North American Datum 1983.

We, A. Bert Skeesick, Cadastral Surveyor, and Robert H. Browning, Surveying Technician, HEREBY CERTIFY upon honor, that in pursuance of special instructions bearing date of the 8th day of March, 2004, we have retraced a portion of the east boundary township 31 south, range 4 west, of the Willamette Meridian, in the State of Oregon. Said retracement has been made in strict conformity with said special instructions, the Manual of Instructions for the Survey of the Public Lands of the United States, and in specific manner described on this plat.

Cadastral Surveyor — January 10, 2007 Date

Surveying Technician — Jan 10, 2007 Date

LEGEND

◇ Original corner previously remonumented

UNITED STATES DEPARTMENT OF THE INTERIOR
BUREAU OF LAND MANAGEMENT

Portland, Oregon

The retracement represented by this plat, having been correctly executed in accordance with the requirements of law and the regulations of this Bureau, is hereby accepted.

For the Director

Mary J. M. Hartel

Chief Cadastral Surveyor of Oregon

January 26, 2007
Date

600 300 0 600 1200 1800 2400 3000 3600 4200 4800

Scale in Feet

R.L.L.