TOWNSHIP 31 SOUTH, RANGE 5 WEST, OF THE WILLAMETTE MERIDIAN, OREGON.

DEPENDENT RESURVEY

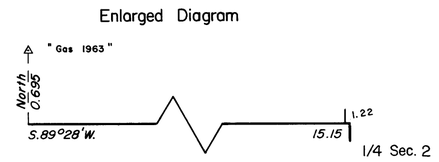

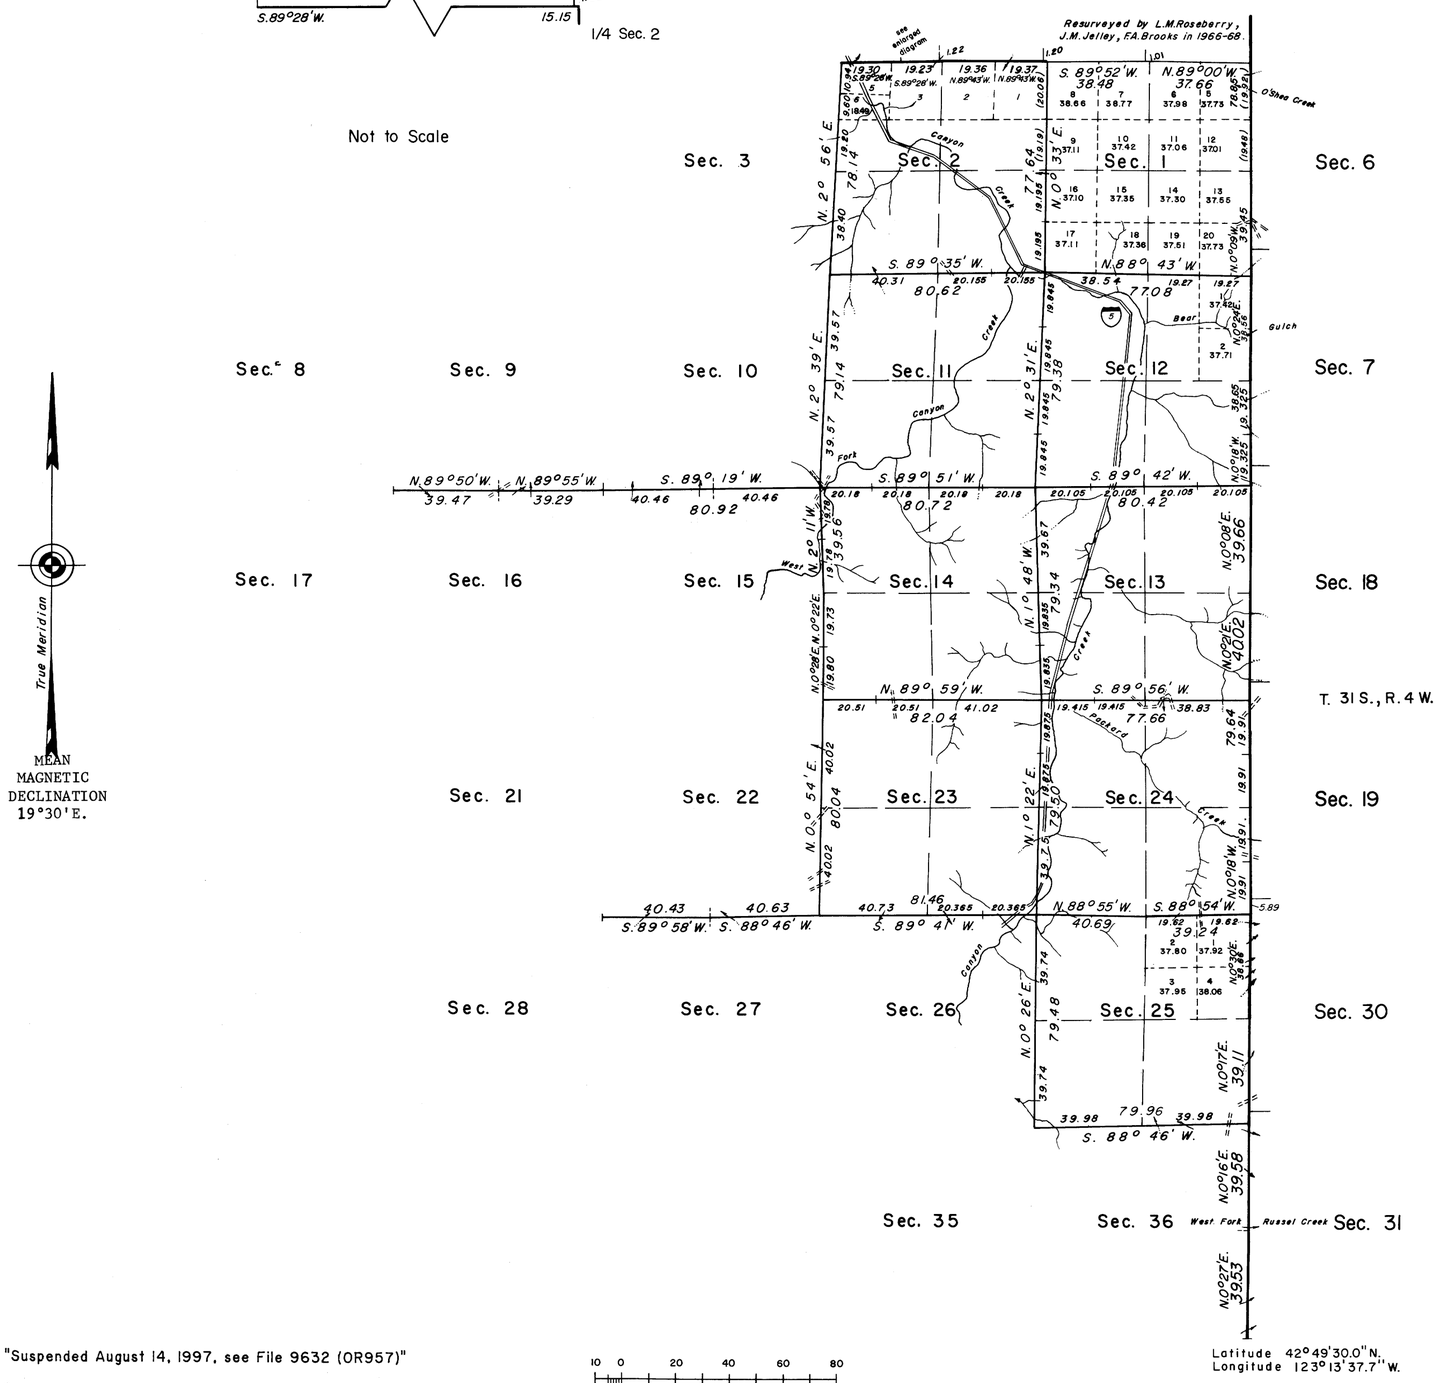

This plat represents a dependent resurvey of the east boundary, and a portion of the north boundary and subdivisional lines, T. 31 S., R. 5 W., Willamette Meridian, Oregon, designed to restore the corners in their true original locations according to the best available evidence.

Except as indicated hereon, the lottings and areas are as shown on the plats approved July 28, 1883, and June 30, 1920, and the plat accepted December 28, 1970.

The east boundary of the township was surveyed by Butler Ives and George W. Hyde, in 1854.

The north boundary of the township was surveyed by Nathaniel Ford, in 1854.

A portion of the subdivisional lines was surveyed, and the east three miles of the north boundary and the east boundary of section 1 were resurveyed by William H. Byars, in 1882.

Portions of the east boundary of the township were resurveyed and closing corners were established for T. 31 S., R. 4 W., by William M. Bushey, in 1894.

A portion of the subdivisional lines were resurveyed by Hans W. Thielsen, in 1955.

A portion of the north boundary and subdivisional lines were resurveyed by John M. Jelley, Lynn M. Roseberry, and Floyd A. Brooks, in 1966-68.

The resurvey was executed by Daniel L. Berry and Charles E. Akin, Jr., Cadastral Surveyors, from September 20, 1972, to June 25, 1973, under Special Instructions dated September 15, 1972, which provide for the surveys included under Group No. 800, Oregon.

UNITED STATES DEPARTMENT OF THE INTERIOR
BUREAU OF LAND MANAGEMENT
Washington, D.C. March 3, 1978

This plat is strictly conformable to the approved field notes, and the survey, having been correctly executed in accordance with the requirements of law and the regulations of this Bureau, is hereby accepted.

For the Director

Acting Chief, Division of Cadastral Survey

"Suspended August 14, 1997, see File 9632 (OR957)"

"Suspension Lifted, June 29, 2000, File 9632 (OR957). Refer to plat accepted November 15, 1999."

Timber in this area consists of fir, hemlock, cedar, pine, oak, madrone, chinquapin, alder, and maple.

TEB

JPK