8095

FILED
Date: 2/10/2020 By: JC
This survey consists of:
Map: 2019-1 (2 PGS)
VOL 59
PAGES 23721-23739

ORIGINAL

SHEET 1 OF 2

TOWNSHIP 31 SOUTH, RANGE 5 WEST, OF THE WILLAMETTE MERIDIAN, OREGON

DEPENDENT RESURVEY, SUBDIVISION OF SECTION 2, AND SURVEY

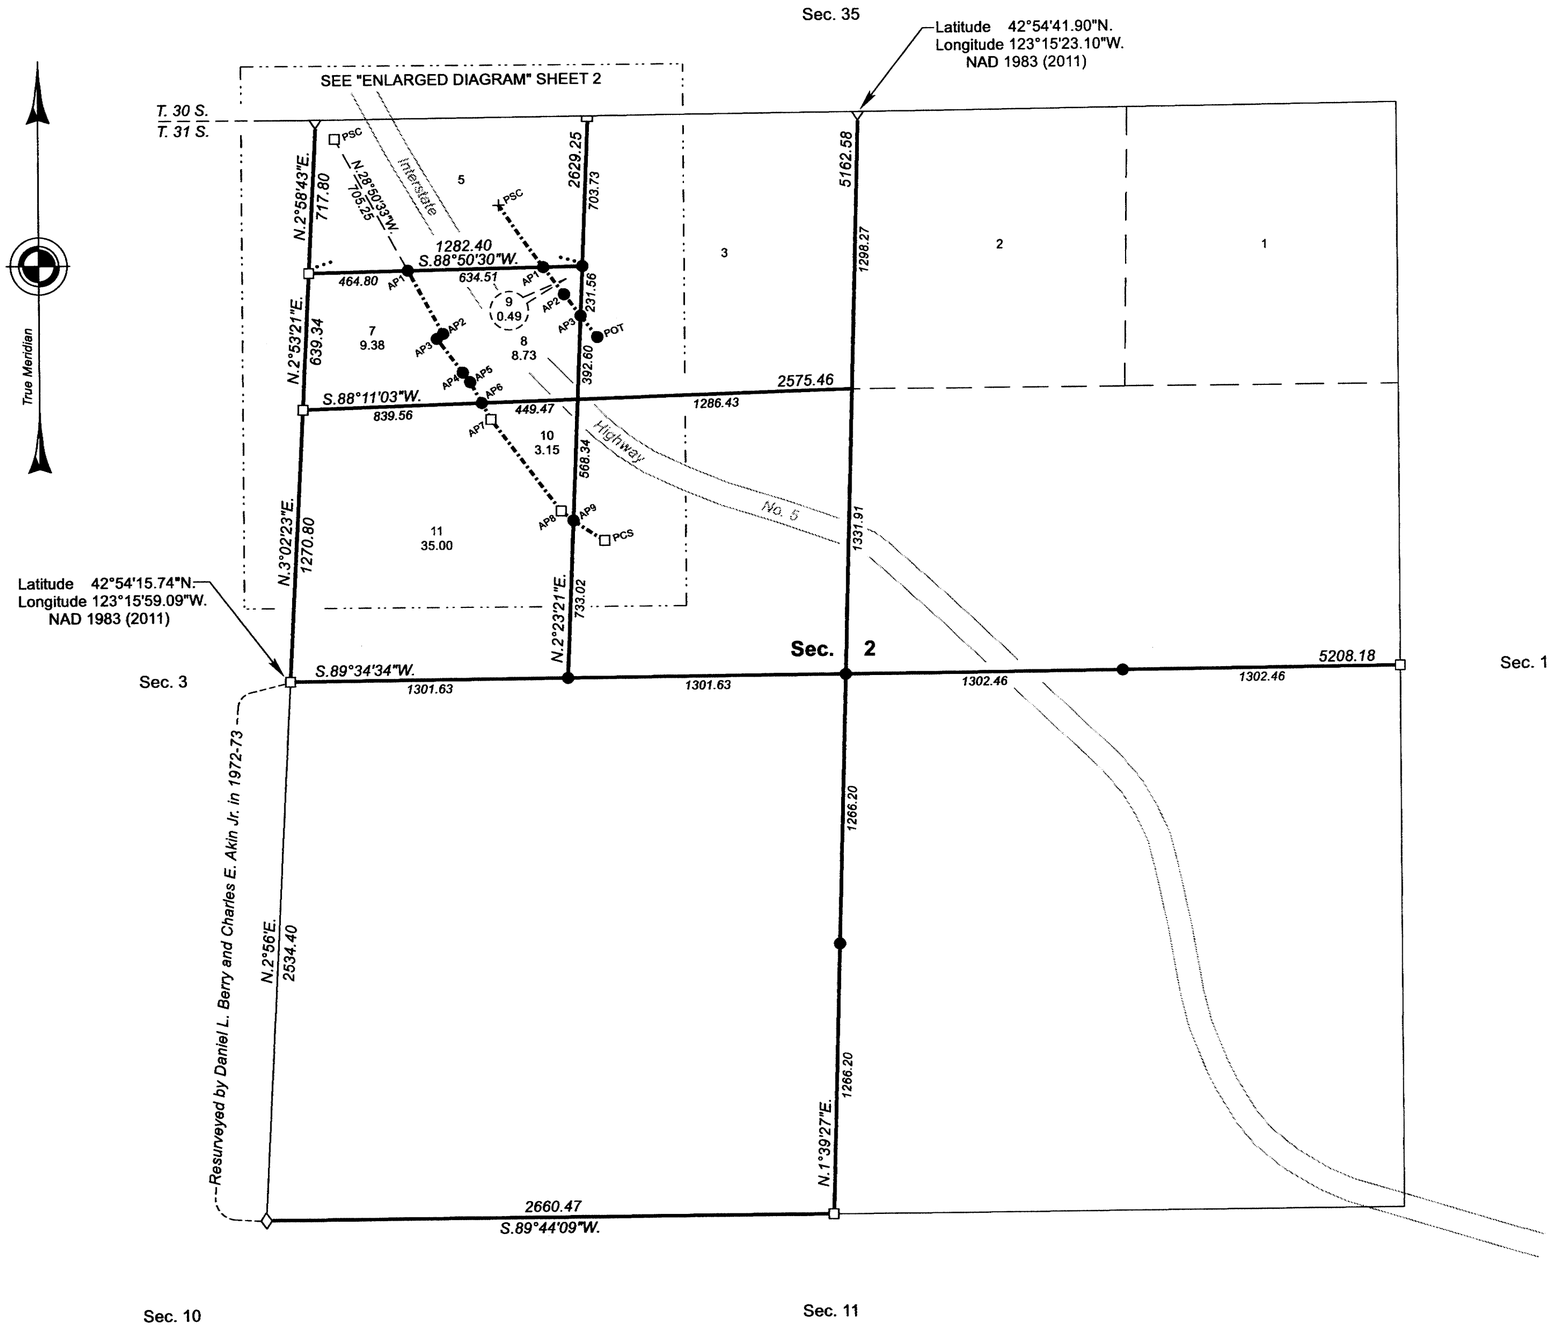

500 250 0 500 1000 1500 2000
Scale in Feet

DOUGLAS COUNTY SURVEYOR

A history of surveys, corner descriptions, and other relevant information are contained in the field notes.

This plat represents the dependent resurvey of a portion of the subdivisional lines, designed to restore the corners in their true original locations according to the best available evidence, and the subdivision of section 2 and survey of a portion of the easterly and westerly rights-of-way of Interstate Highway No. 5 in section 2, Township 31 South, Range 5 West, Willamette Meridian, Oregon.

Official areas based on the measurements of this survey have been returned for Federal interest land where indicated. Aliquot part legal subdivisions retain their aliquot characteristics and refer to precisely the same land as that which was previously identified by its original survey or description. A lot can only be subdivided by survey or supplemental plat. Except as indicated hereon, the lottings and areas are as shown on the plat approved July 28, 1883, and the plat accepted March 3, 1978.

Survey executed by Markell G. Hamm, Cadastral Surveyor, beginning June 27, 2018, and completed September 1, 2018, pursuant to special instructions approved June 27, 2018, for Group No. 2927, Oregon.

LEGAL SUBDIVISION	OFFICIAL ACRES
SECTION 2	
NE1/4 SW1/4	37.99
NW1/4 SW1/4	37.94
SW1/4 SW1/4	38.35
SE1/4 SW1/4	38.41
TOTAL AREA FEDERAL INTEREST LAND RESURVEYED	152.69
TOTAL AREA FEDERAL INTEREST LAND SURVEYED	56.75

LEGEND

- ◇ Original corner previously remonumented
- □ Corner previously established or reestablished
- ● Corner established or reestablished this survey
- + Corner point calculated, no monument set
- Easterly and westerly rights-of-way of Interstate Highway No. 5

UNITED STATES DEPARTMENT OF THE INTERIOR
BUREAU OF LAND MANAGEMENT

Portland, Oregon

This plat is strictly conformable to the approved field notes, and the survey, having been correctly executed in accordance with the requirements of law and the regulations of this Bureau, is hereby accepted.

For the Director

Mary J. M. Hatch

Chief Cadastral Surveyor of Oregon

November 21, 2019

Date

OFFICIALLY FILED: 1/21/2020

JJ

TOWNSHIP 31 SOUTH, RANGE 5 WEST, OF THE WILLAMETTE MERIDIAN, OREGON

DEPENDENT RESURVEY, SUBDIVISION OF SECTION 2, AND SURVEY

SHEET 2 OF 2

FILED
Date: 2/10/2020 By: JC
This survey consists of:
Map: 2019-1 (2 PGS)
VOL 59
PAGES 23721-23739
DOUGLAS COUNTY SURVEYOR

OFFICIALLY FILED: 1/21/2020

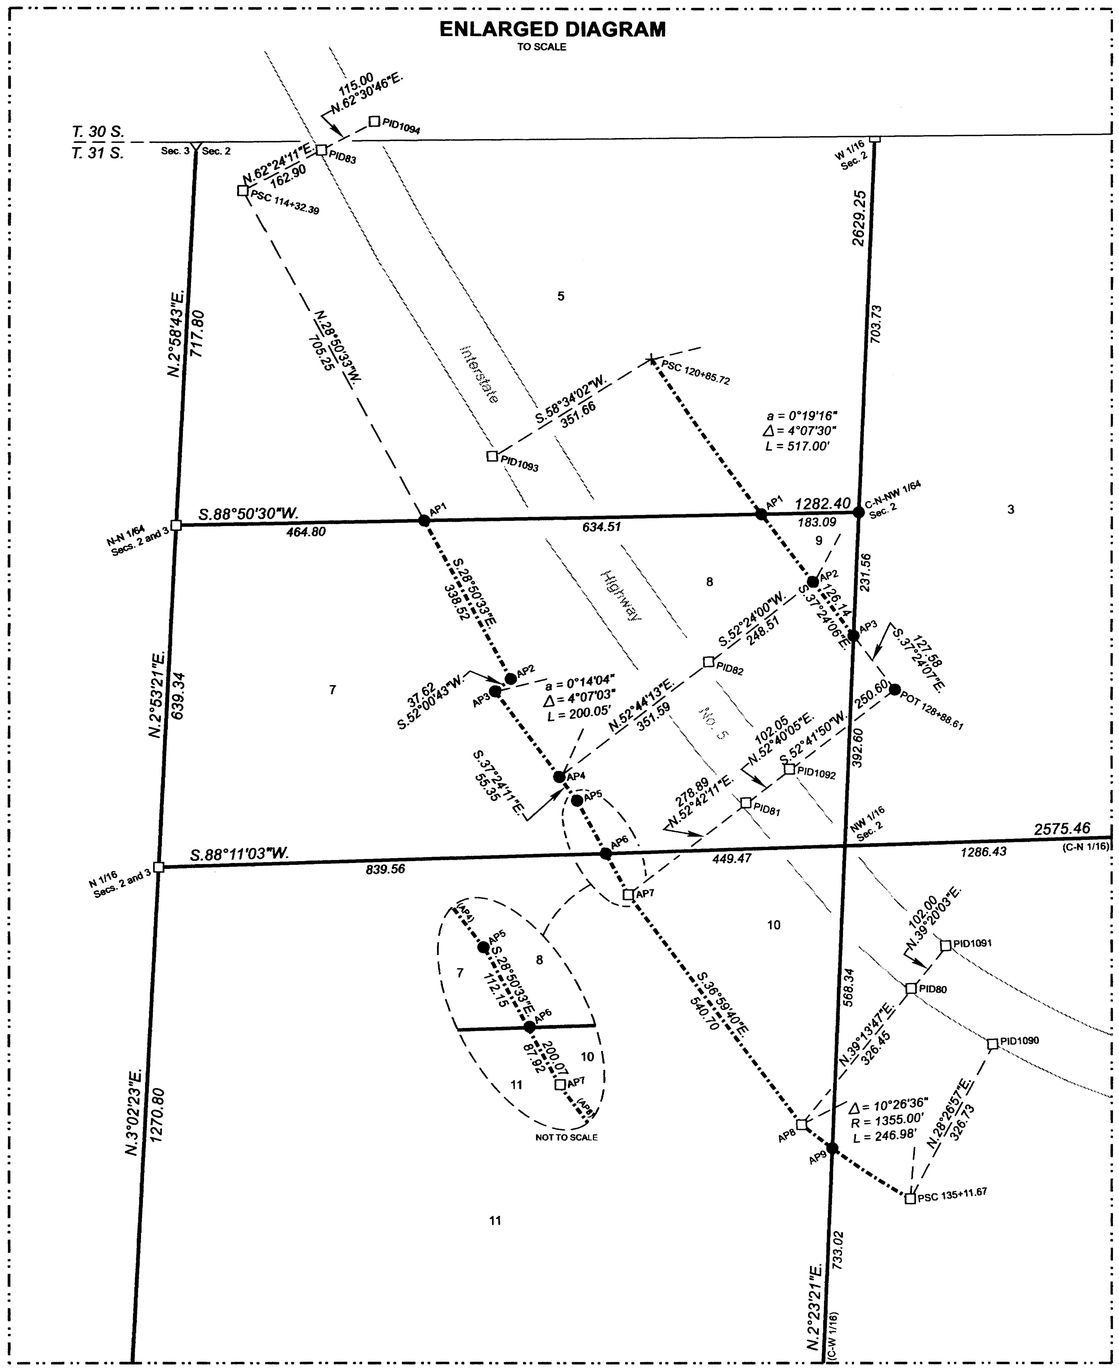

LEGEND

- ◇ Original corner previously remonumented
- □ Corner previously established or reestablished
- ● Corner established or reestablished this survey
- + Corner point calculated, no monument set
- Easterly and westerly rights-of-way of Interstate Highway No. 5

200 100 0 200 400 600 800
Scale in Feet

UNITED STATES DEPARTMENT OF THE INTERIOR
BUREAU OF LAND MANAGEMENT

Portland, Oregon

This plat is strictly conformable to the approved field notes, and the survey, having been correctly executed in accordance with the requirements of law and the regulations of this Bureau, is hereby accepted.

For the Director

Mary J. M. Hartel

Chief Cadastral Surveyor of Oregon

November 21, 2019

Date

JJ