5343

ORIGINAL

TOWNSHIP 31 SOUTH, RANGE 6 WEST, OF THE WILLAMETTE MERIDIAN, OREGON.

DEPENDENT RESURVEY AND SUBDIVISION

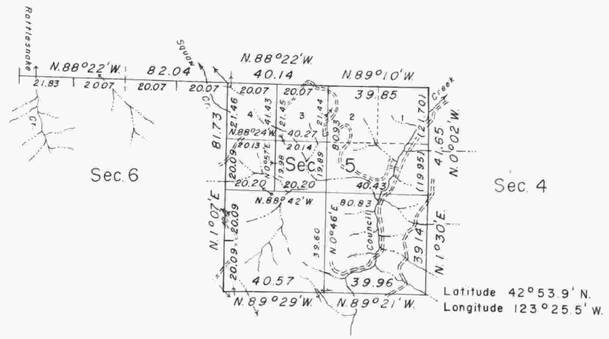

Mean
Magnetic Declination
19°15'E.

10 5 0 10 20 30 40 50 60 70 80
Chains

Area resurveyed: 654.48 Acres

This plat represents a retracement and reestablishment of a portion of the north boundary, a portion of the subdivisional lines, and subdivision of section 5, T. 31 S., R. 6 W., designed to restore the corners in their true original locations according to the best available evidence. The designations and areas are as shown on the plat approved October 5, 1882.

The north boundary was surveyed by Addison R. Flint in 1855. The subdivisional lines were surveyed by William H. Byars in 1882.

These surveys were executed by John M. Jelley, July 20 to August 11, 1965, under Special Instructions dated June 11, 1965, which provide for the surveys included under Group No. 585, Oregon.

Timber in this area consists of fir, cedar, madrone, maple, yew, pine, dogwood, alder, oak, and myrtle.

UNITED STATES DEPARTMENT OF THE INTERIOR
BUREAU OF LAND MANAGEMENT
Washington, D. C. July 12, 1966

This plat is strictly conformable to the approved field notes, and the survey, having been correctly executed in accordance with the requirements of law and the regulations of this Bureau, is hereby accepted.

For the Director

E. E. Remington

Chief, Division of Engineering

LPL