7419

TOWNSHIP 31 SOUTH, RANGE 6 WEST, OF THE WILLAMETTE MERIDIAN, OREGON

DEPENDENT RESURVEY

FILED
Date: 7/20/2010 By: JC
This survey consists of:
~~Map:~~ BLM LINE NOTES
~~Narrative:~~ VOL. 56
~~Corner Rpt:~~ PGS 22158-22168
DOUGLAS COUNTY
SURVEYOR

A history of surveys is contained in the field notes.

This plat represents the dependent resurvey of a portion of the subdivisional lines, T. 31 S., R. 6 W., Willamette Meridian, Oregon, designed to restore the corners in their true original locations according to the best available evidence.

The survey was performed utilizing both conventional (directly measured angles and distances) and NAVSTAR Global Positioning System (GPS) satellite techniques. The GPS measurements utilized dual frequency, carrier phase GPS receivers. The baselines were computed in and adjusted using a least squares adjustment routine. Conventionally measured distances and directions have been adjusted using a least squares adjustment routine. The adjusted bearings and distances are reported to the nearest second and 0.01 foot.

Except as shown hereon, the lottings and areas are as shown on the plat approved October 5, 1882.

The survey was executed by A. Bert Skeesick, Cadastral Surveyor, and Robert H. Browning, Surveying Technician, beginning April 22, 2008, and completed June 3, 2008, pursuant to Special Instructions dated February 21, 2008, under Group Number 2193, Oregon.

Sec. 6 Sec. 5

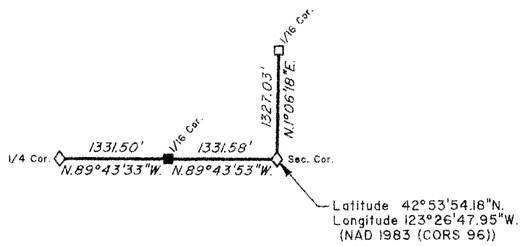

Sec. 7 Sec. 8 Sec. 9

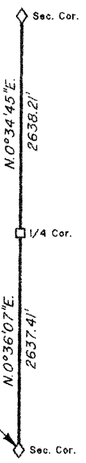

Latitude 42°52'10.13"N.
Longitude 123°25'37.48"W.
(NAD 1983 (CORS 96))

Sec. 13 Sec. 18 Sec. 17 Sec. 16

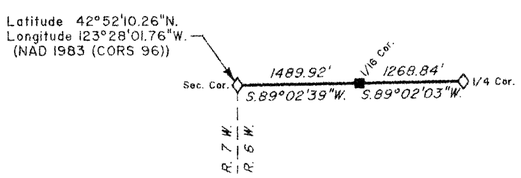

Sec. 24 Sec. 19 Sec. 20 Sec. 21

LEGEND	
◇	Original corner previously remonumented
□	Corner previously established or reestablished
■	Corner previously established; remonumented this survey

UNITED STATES DEPARTMENT OF THE INTERIOR
BUREAU OF LAND MANAGEMENT

Portland, Oregon

This plat is strictly conformable to the approved field notes, and the survey, having been correctly executed in accordance with the requirements of law and the regulations of this Bureau, is hereby accepted.

For the Director

Mary J. M. Hall

Chief Cadastral Surveyor of Oregon

May 4, 2010

Date

JJ