Byers under Contract 448, Book 277, p. 497 surveyed in 1882

Township 31 South Range 7 West

Area	
Sections	Acres
1	160.00
2	620.00
3	620.00
4	601.00
5	400.00
Total	2221.00

General Description

The land in this fractional Township is a fair average 2d rate grass and timbered land. There are some small rich bottoms along the creeks containing good first rate farming lands. The uplands are generally rolling and only fit for grazing purposes, well watered. Cow creek runs through sec 1 & 4. Timber, chiefly Fir, Pine, Cedar, Laurel, Oak, Maple and Fish is well distributed. There are two settlements one in the N.E. quarter and the other in the S.W. quarter of sec. 4. Gold is found along on the bars of Cow creek in sufficient quantities to their being work. The local attraction in this Township is so great that no reliance can be placed in the needle. A peculiar mountain borders the north boundary of fractional secs 4, 5. being almost perpendicular on the south side 1000 feet high indented by fissures and caverns. and insurmountable.

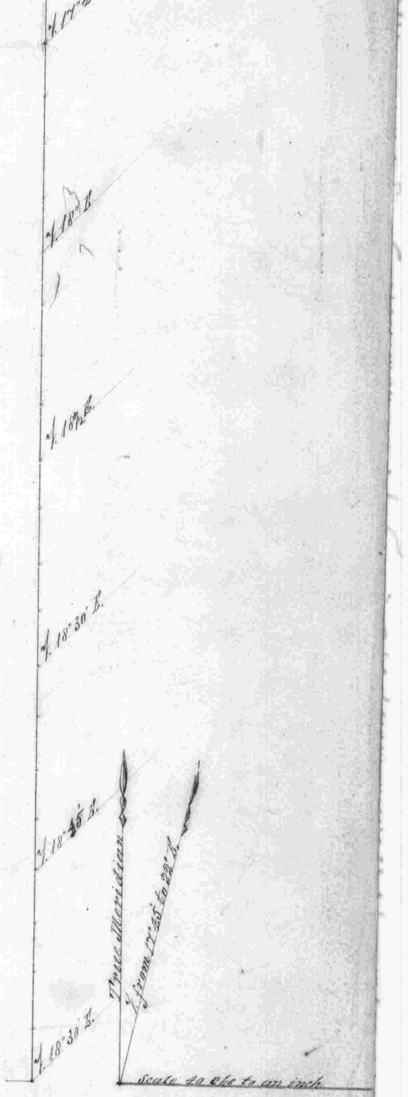

Lines	Contractor	Contract No	Contract Date	Amount Surveyed Miles	Chains	Links	Commenced	Completed
Subdivisional	W. H. Byers	152	June 3d 1871	8	45	88	May 7th 1872	May 9th 1872

The above Map of the subdivisional lines in fractional T. 31 S. R. 7 W. Will, Mer. Oregon is strictly conformable to the original field notes of the survey thereof on file in this Office which have been examined and approved.

U.S. Sur. Genl. Office
Eugene City Ore. Jan 8th 1873

W. H. Odell
Sur. Genl.