TOWNSHIP 31 SOUTH, RANGE 9 WEST, OF THE WILLAMETTE MERIDIAN, OREGON

DEPENDENT RESURVEY AND SUBDIVISION OF SECTION 19

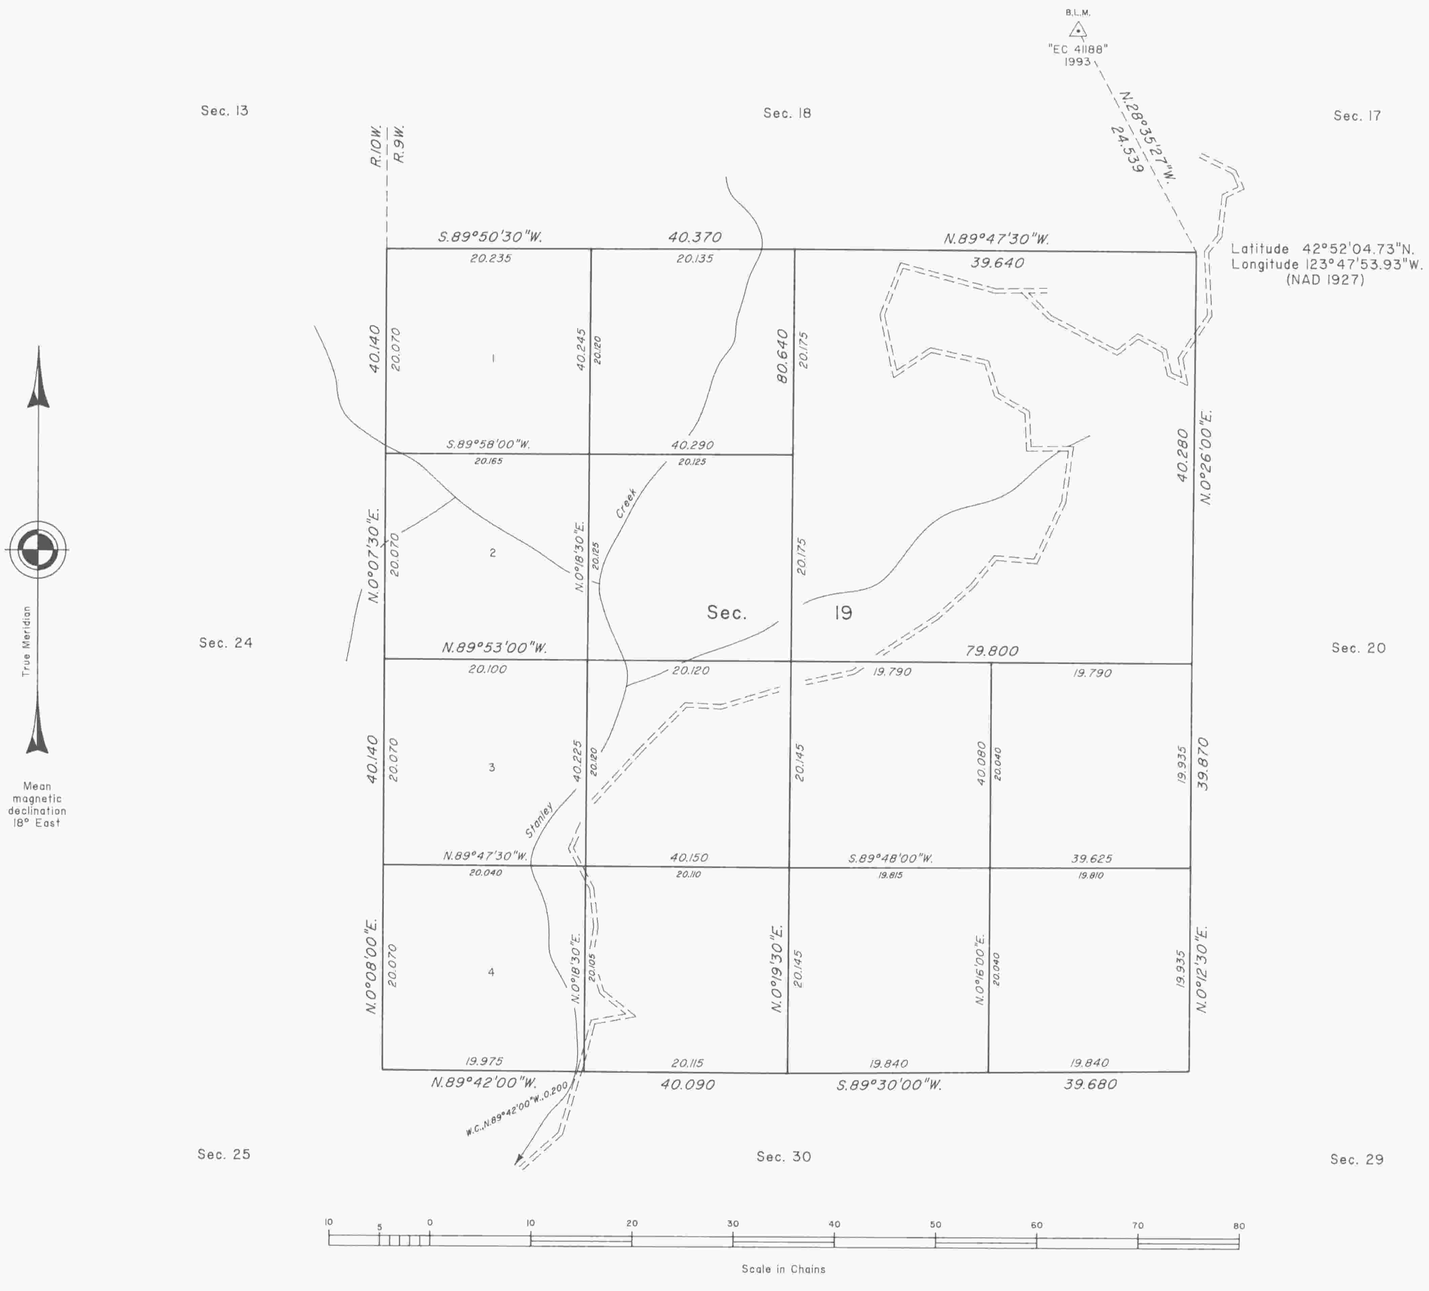

A history of surveys is contained in the field notes.

This plat represents a dependent resurvey of portions of the west boundary and subdivisional lines, T. 31 S., R. 9 W., Willamette Meridian, Oregon, designed to restore the corners in their true original locations according to the best available evidence, and the subdivision of section 19.

The lottings and areas are as shown on the plat approved April 3, 1902.

The survey was executed by Francis J. Simon, Cadastral Surveyor, beginning July 12, 1993, and completed October 6, 1993, pursuant to Special Instructions dated March 1, 1993, under Group Number 1679, Oregon.

Timber in this area consists of sugar pine, white fir, Douglas fir, hemlock, Port Orford cedar, Pacific yew, canyon live oak, alder, chinquapin, madrone, and big leaf maple.

UNITED STATES DEPARTMENT OF THE INTERIOR
BUREAU OF LAND MANAGEMENT

Portland, Oregon November 27, 1995

This plat is strictly conformable to the approved field notes, and the survey, having been correctly executed in accordance with the requirements of law and the regulations of this Bureau, is hereby accepted.

For the Director

Wayne M. Haldane

Chief Cadastral Surveyor of Oregon

O.S.B.