1424

Township No. 31 South, Range No. 10 West of the Willamette Meridian, Oregon.

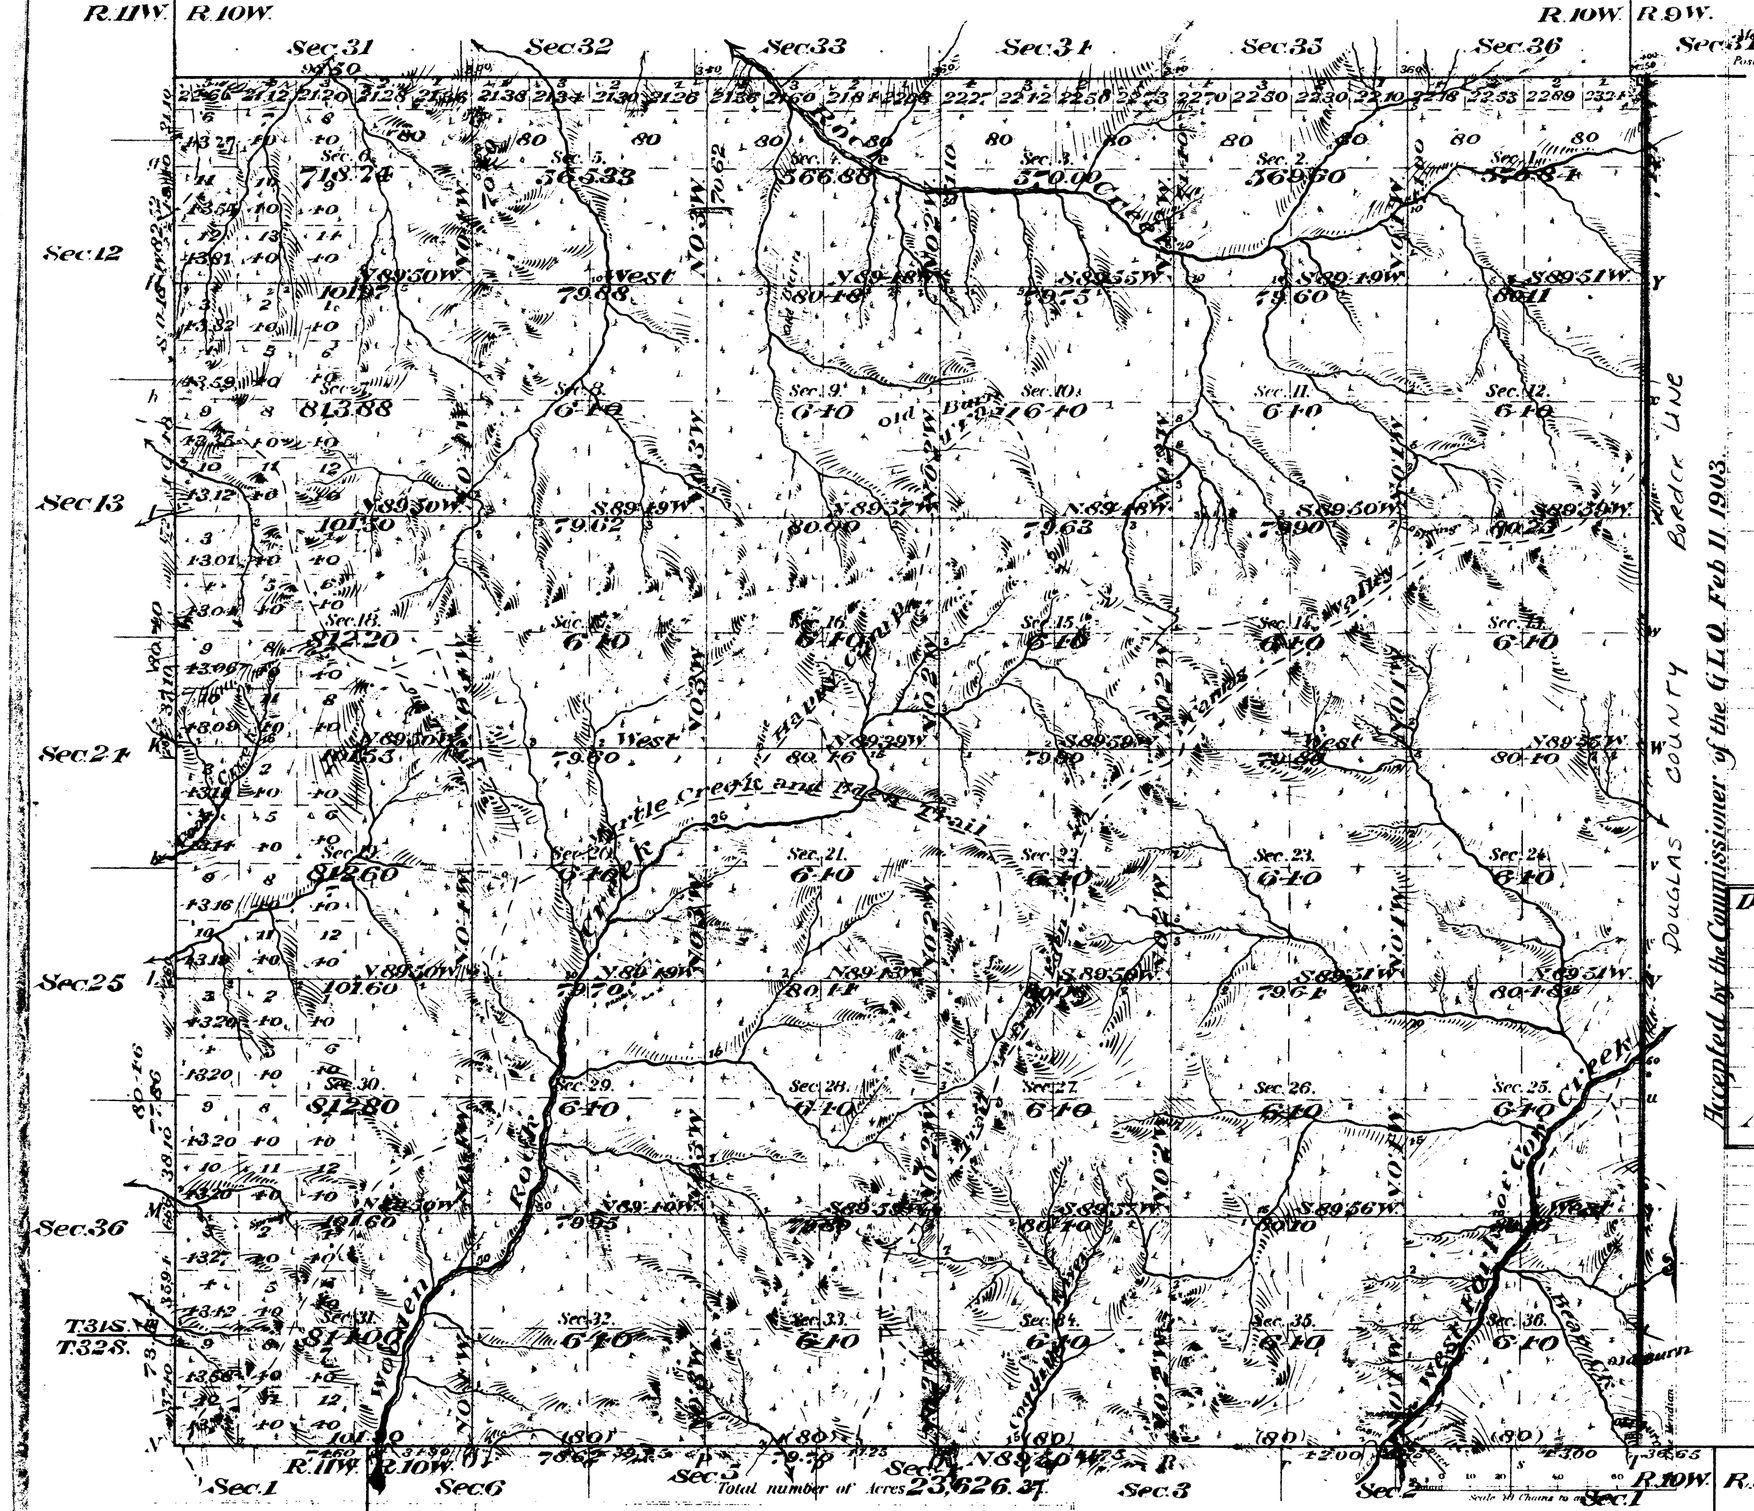

Meanders of

Posts	Courses	Ch's Lk's	Posts	Courses	Ch's Lk's	Posts	Courses	Ch's Lk's

Accepted by the Commissioner of the G.L.O. Feb. 11, 1903.

Deposited by Oregon & California Railroad Co.

For Field Work	$137.00
" Office "	86.00
" Field Examination	126.00
Cost of Field Work	
" " " Examination	$123.00
" " Office Work	$82.00
Amount Refunded	

Surveys Designated	By Whom Surveyed	Date of Contract	Amount of Surveys M.	Ch's	Lk's	When Surveyed	No. of Contract
Township lines } East Bdy.	W.H. Byars	Dec. 20 1900				April 25-26, 1901	727
Subdivisions }	" " "	" " "	60	62	85	May 27-June 2, 1901	"
Resurveys Bdy.	" " "	" " "				May 23-25, 1901	"
Retracements } Sec. 36, T. 30 S. R. 31	" " "	" " "					"
Connections	" " "	" " "	30	80			"
North Bdy.	W.M. Bushey					1893	613
West "	W.P. Wright					1882	442
South "	R.S. Dickerson					1883	474

The above Map of Township No. 31 South, of Range No. 10 West of the Willamette Meridian Oregon is strictly conformable to the field notes of the survey thereof on file in this Office, which have been examined and approved.

Surveyor General's Office,
Portland, Oregon April 13th 1902

Henry Hildebrand
Sur. Gen. for Oregon