TOWNSHIP 32 SOUTH, RANGE 1 WEST, OF THE WILLAMETTE MERIDIAN, OREGON

DEPENDENT RESURVEY AND SUBDIVISION OF SECTION 19

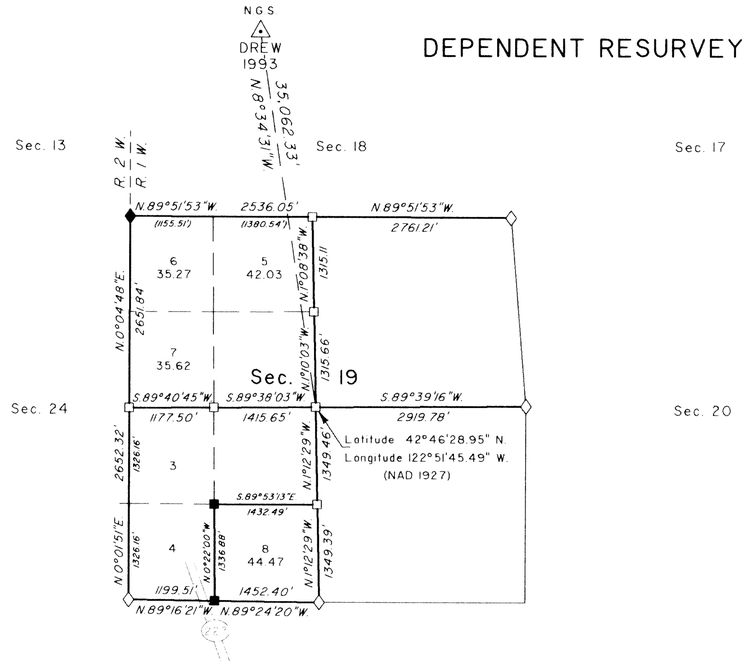

Mean magnetic declination 18° East

A history of surveys is contained in the field notes.

This plat represents a dependent resurvey of a portion of the south and west boundaries, and subdivisional lines, T. 32 S., R. 1 W., Willamette Meridian, Oregon, designed to restore the corners in their true original locations according to the best available evidence, and the subdivision of section 19.

Measured distances and directions have been adjusted by Cadastral Measurement Management for Windows (WinCMM), computer software that incorporates a least squares adjustment routine. The adjusted bearings and distances are reported to the nearest second and 0.01 foot.

Except as shown hereon, the lottings and areas are as shown on the plat approved April 10, 1884.

The survey was executed by Francis J. Simon, Cadastral Surveyor, beginning April 22, 2002, and completed June 26, 2002, pursuant to Special Instructions dated February 11, 2002, under Group Number 2007, Oregon.

Timber in this area consists of cedar, fir, and pine.

The tie to the geodetic control station is reported as mean bearing and sea level distance.

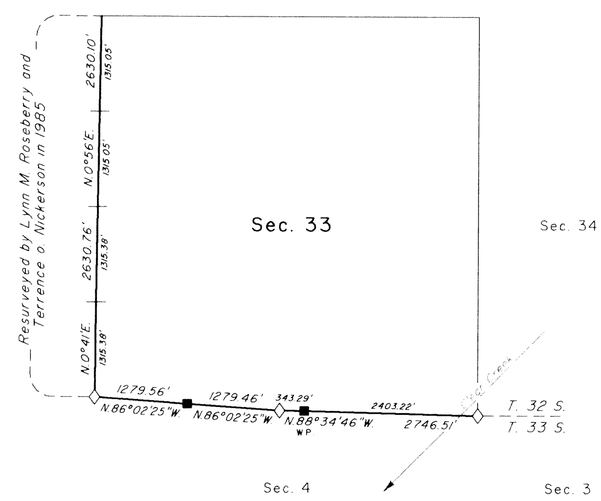

Scale in Feet

LEGEND

- ◇ Original corner previously remonumented
- ◆ Original corner remonumented this survey
- □ Corner previously established or reestablished
- ■ Corner previously established; remonumented this survey

UNITED STATES DEPARTMENT OF THE INTERIOR
BUREAU OF LAND MANAGEMENT

Portland, Oregon June 14, 2005

This plat is strictly conformable to the approved field notes, and the survey, having been correctly executed in accordance with the requirements of law and the regulations of this Bureau, is hereby accepted.

For the Director

John P. Tomsuerth, Acting

Chief Cadastral Surveyor of Oregon

DLP