JACKSON COUNTY

TOWNSHIPS 32 AND 33 SOUTH, RANGE 3 WEST, OF THE WILLAMETTE MERIDIAN, OREGON

DEPENDENT RESURVEY, CORRECTIVE DEPENDENT RESURVEY AND SUBDIVISION OF SECTION

FILED
Date: 11/25/2015 By: JC
This survey consists of:
Map: T32-3 2015-2
Narrative: VOL. 58 PAGES
Corner Rpt: 23278-23287
DOUGLAS COUNTY SURVEYOR

OFFICIALLY FILED: 11/9/2015

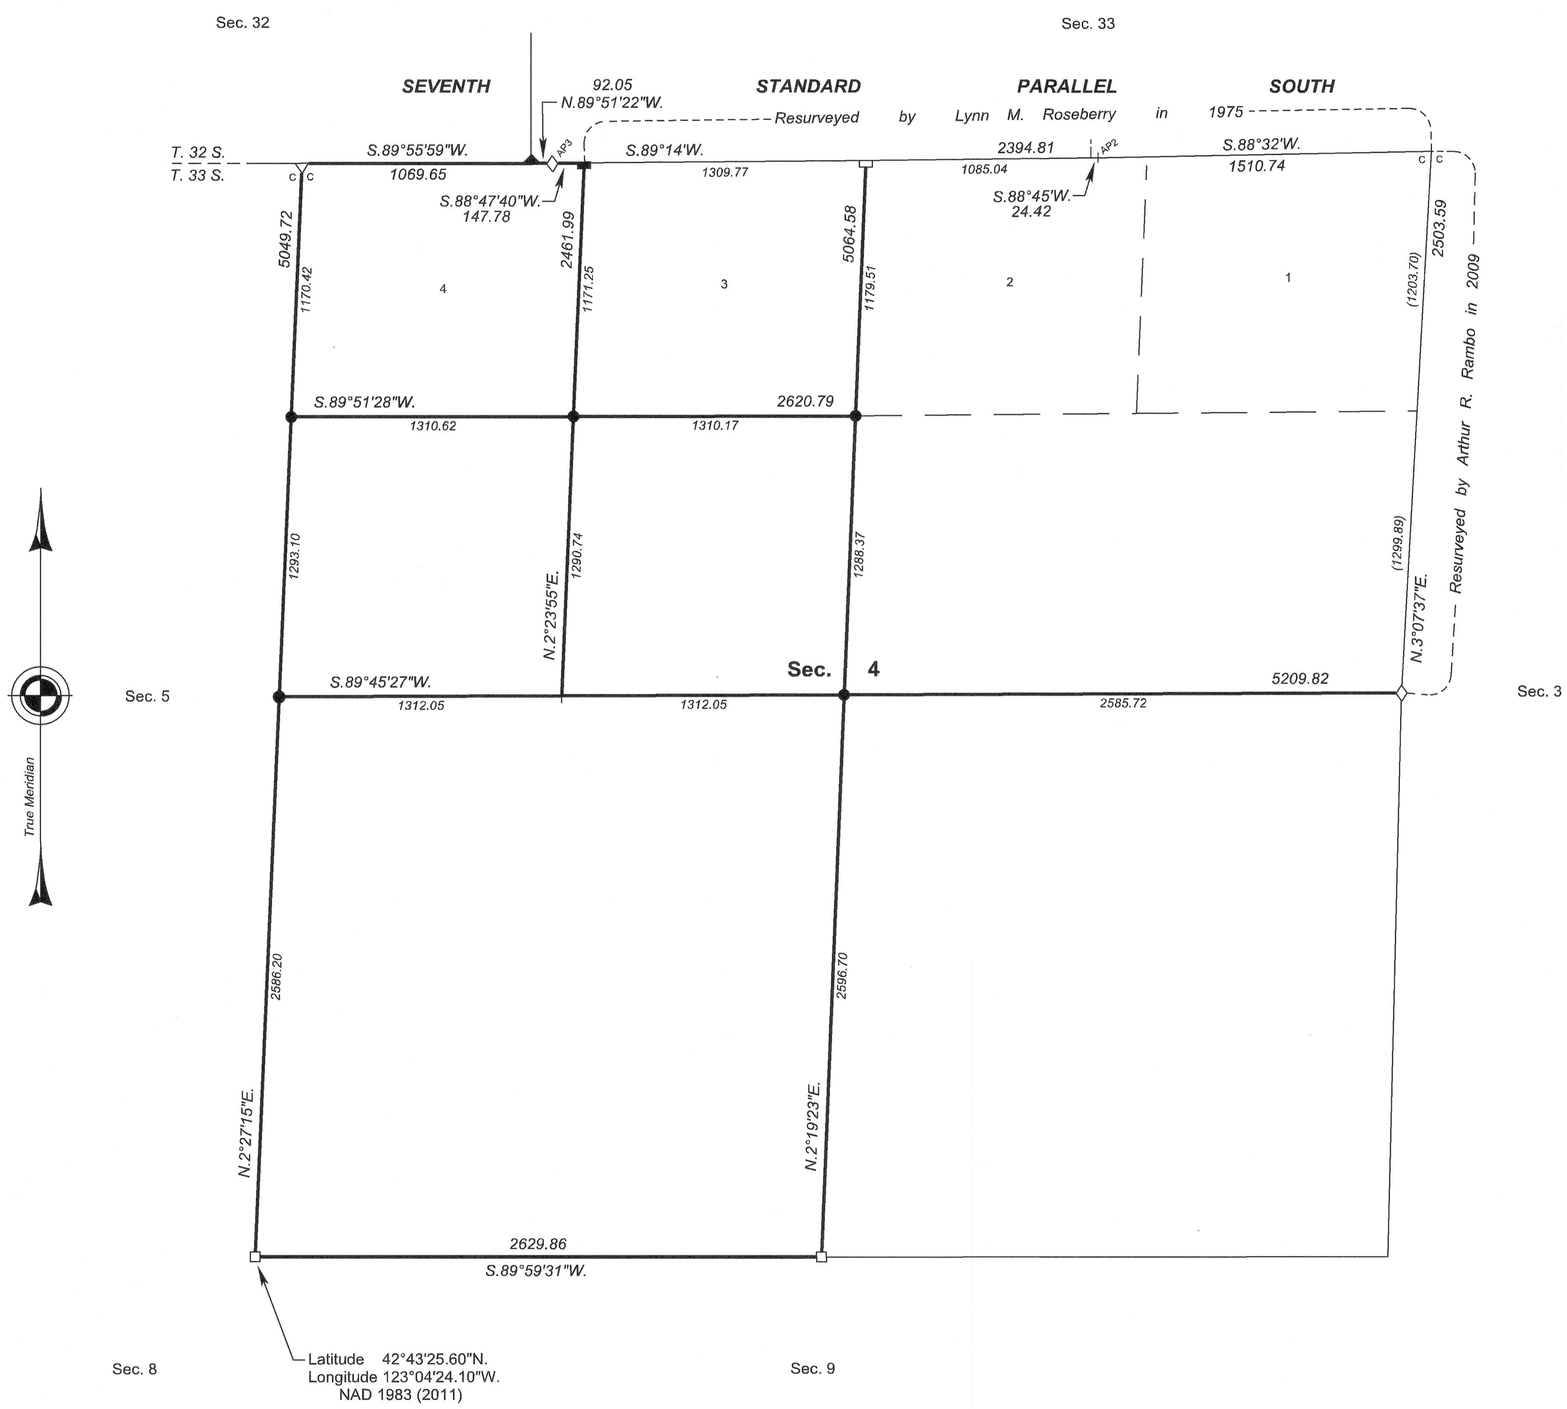

A history of surveys, corner descriptions, and other relevant information are contained in the field notes.

This plat represents the dependent resurvey of a portion of the south boundary of Township 32 South, Range 3 West (Seventh Standard Parallel South), the corrective dependent resurvey of a portion of the subdivisional lines, and the dependent resurvey of a portion of the subdivisional lines, designed to restore the corners in their true original locations according to the best available evidence, and the subdivision of section 4, Township 33 South, Range 3 West, Willamette Meridian, Oregon.

Official areas based on the measurements of this survey have been returned for Federal interest land where indicated. Aliquot part legal subdivisions retain their aliquot characteristics and refer to precisely the same land as that which was previously identified by its original survey or description. A lot can only be subdivided by survey or supplemental plat. Except as indicated hereon, the lottings and areas are as shown on the plat approved March 31, 1885.

Survey executed by Arthur R. Rambo, Cadastral Surveyor, beginning April 8, 2014, and completed May 13, 2014, pursuant to special instructions approved March 20, 2014, and supplemental special instructions approved February 24, 2015, for Group No. 2740, Oregon.

LEGAL SUBDIVISION	OFFICIAL ACRES
SECTION 4	
LOT 1	35.75
LOT 2	35.37
SW1/4 NE1/4	38.41
SE1/4 NE1/4	38.57
LOT 3	35.30
LOT 4	35.14
SW1/4 NW1/4	38.85
SE1/4 NW1/4	38.78
SE1/4 SW1/4	39.05
NW1/4 SW1/4	38.97
SW1/4 SW1/4	39.02
SE1/4 SW1/4	39.10
TOTAL AREA FEDERAL INTEREST LAND RESURVEYED	452.31

LEGEND

- ◇ Original corner previously remonumented
- ◆ Original corner remonumented this survey
- □ Corner previously established or reestablished
- ■ Corner previously established or reestablished; remonumented this survey
- ● Corner established or reestablished this survey
- + Corner point calculated, no monument set

UNITED STATES DEPARTMENT OF THE INTERIOR
BUREAU OF LAND MANAGEMENT

Portland, Oregon

This plat is strictly conformable to the approved field notes, and the survey, having been correctly executed in accordance with the requirements of law and the regulations of this Bureau, is hereby accepted.

For the Director

Mary J. M. Hatch

Chief Cadastral Surveyor of Oregon

September 16, 2015

Date