ORIGINAL

TOWNSHIP 32 SOUTH, RANGE 4 WEST, OF THE WILLAMETTE MERIDIAN, OREGON.

DEPENDENT RESURVEY AND SUBDIVISION

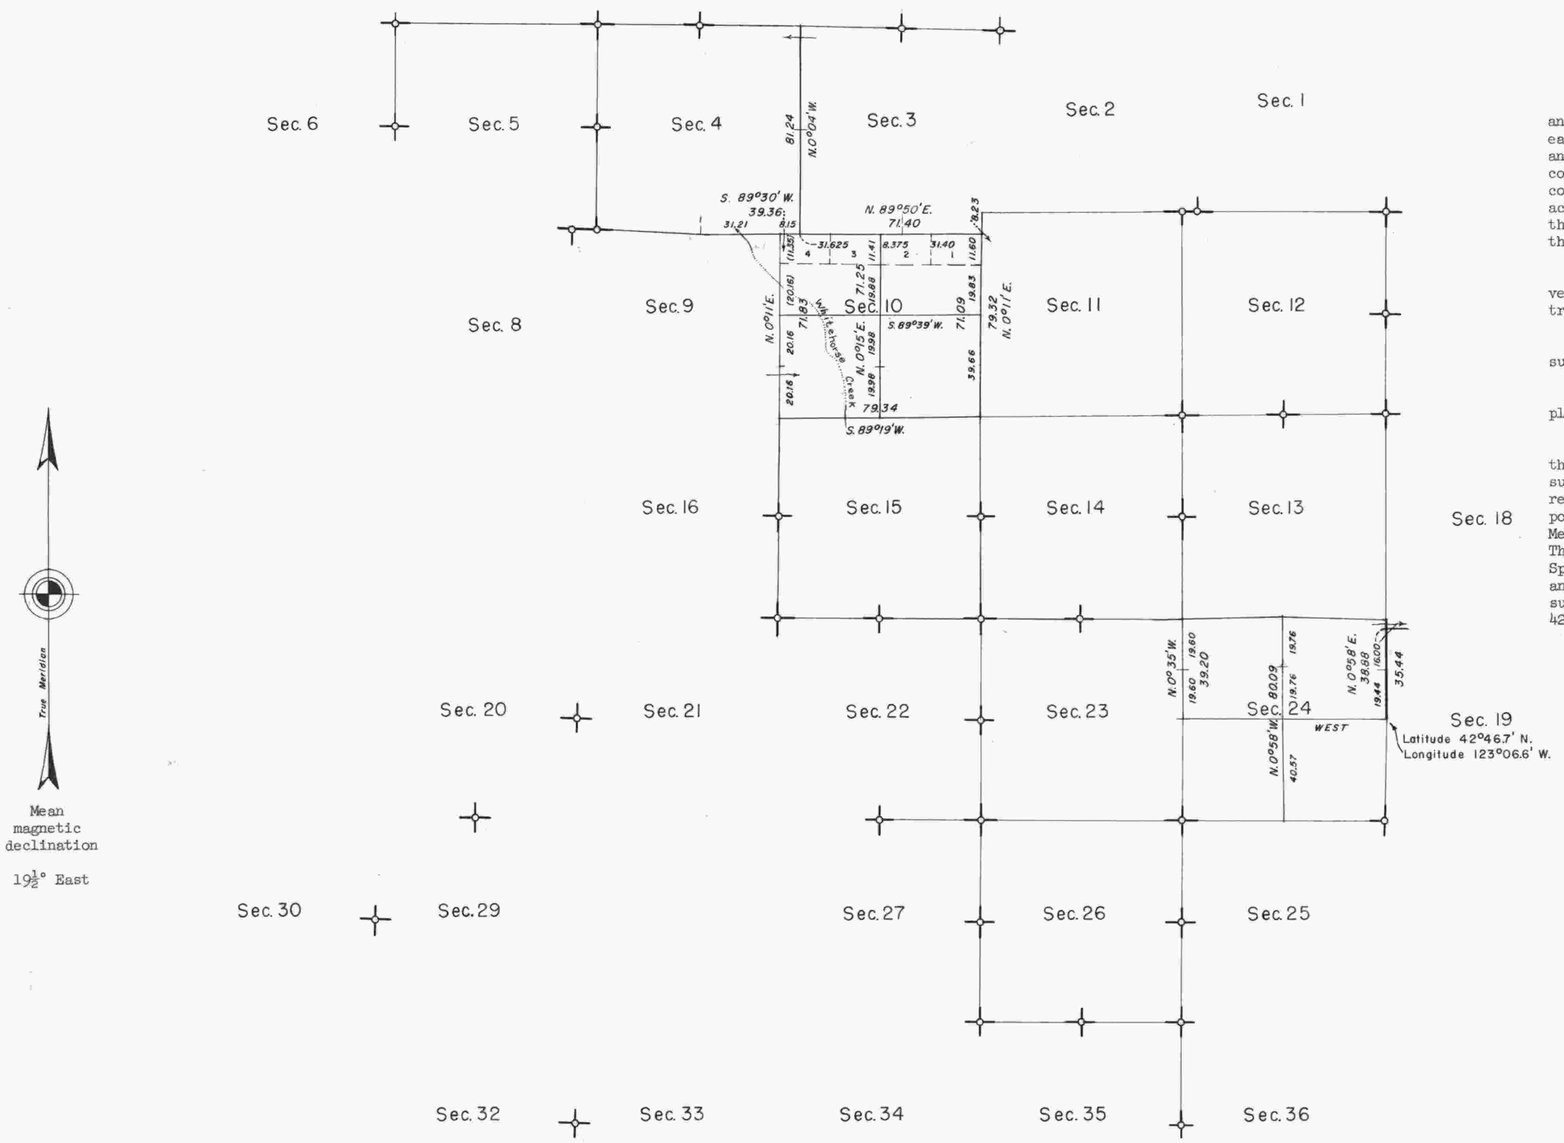

This plat represents a retracement and reestablishment of a portion of the east boundary and subdivisional lines, and remonumentation of certain original corner points designed to restore the corners in their true original location according to the best available evidence; the lottings and areas are as shown on the plat approved March 25, 1898.

A portion of the east boundary surveyed by Carl S. Nicklin in 1897 and retraced by Fred Mensch in 1913.

A portion of the subdivisional lines surveyed by William H. Byars in 1871.

A survey of the township was completed by Carl S. Nicklin in 1897.

Dependent resurvey of a portion of the east boundary and subdivisional lines, subdivision of Sections 10 and 24, and remonumentation of certain original corner points of T. 32 S., R. 4 W., Willamette Meridian, Oregon, executed by Hans W. Thielsen, May 18 to June 19, 1959, under Special Instructions dated May 3, 1957, and March 15, 1959, which provide for the surveys included under Group Nos. 350 and 422, Oregon.

Timber in this area consists of fir, hemlock, pine, cedar, madrona, and chinquapin.

10 5 0 10 20 30 40 50 60 70 80
Chains

Area resurveyed - 571.80 Acres

⟡ corners remonumented in 1959, under Group No. 350

UNITED STATES DEPARTMENT OF THE INTERIOR
BUREAU OF LAND MANAGEMENT
Washington, D.C. November 3, 1960

This plat is strictly conformable to the approved field notes, and the survey, having been correctly executed in accordance with the requirements of law and the regulations of this Bureau, is hereby accepted.

For the Director

Donald B. Clement

Cadastral Engineering Staff Officer

C.A.H.

F.R.H.