MAP FILE M130-68

MAP

SHOWING A SURVEY OF THE D.A. LEVENS PLACER MINING CLAIM NO. 37 IN THE GREEN MOUNTAIN MINING DISTRICT, WEST 1/2 SEC. 28, T.32S., R.4W., W.M., DOUGLAS COUNTY, OREGON.

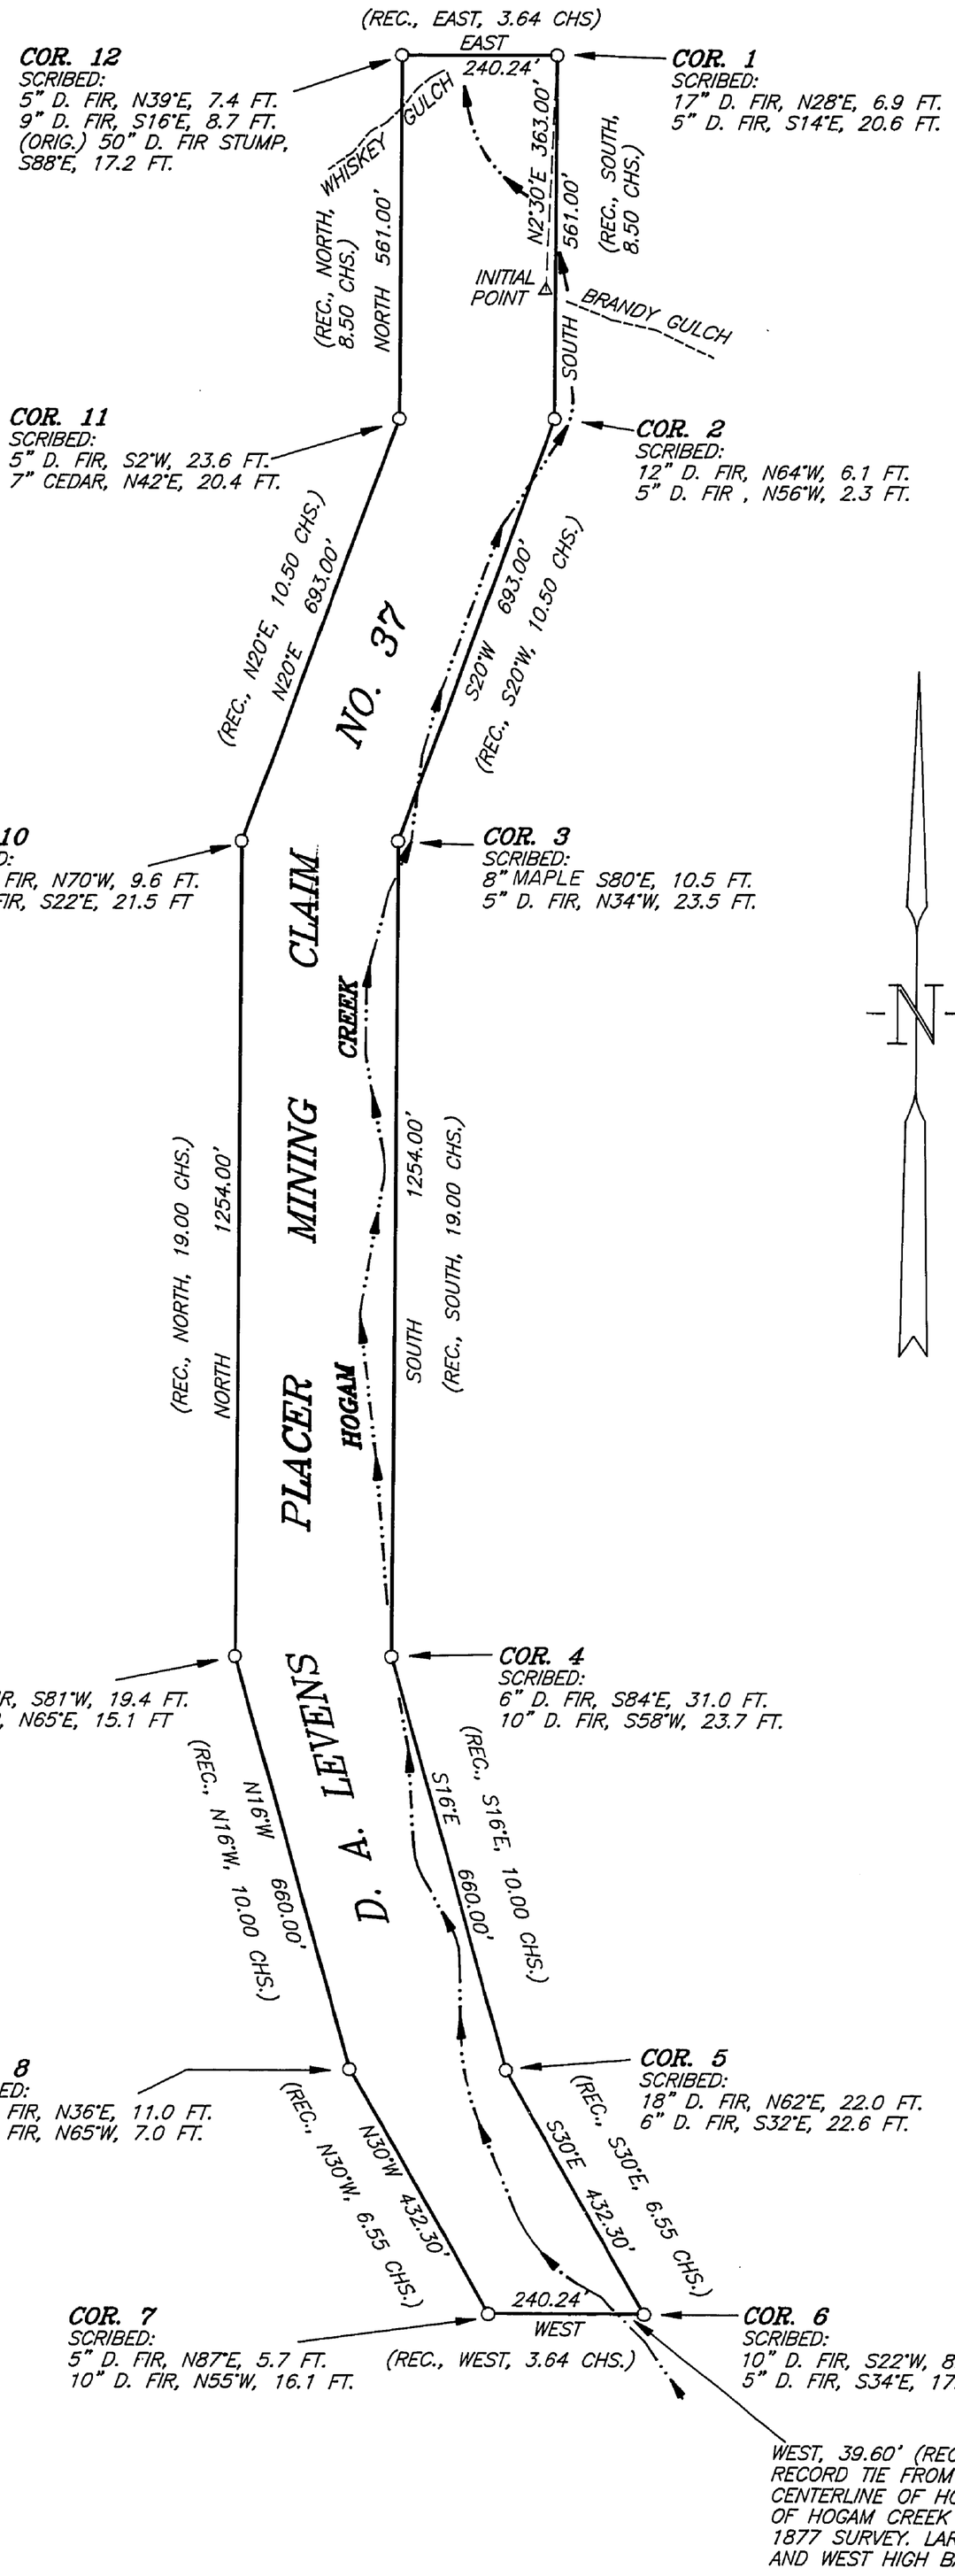

FILED

Date: 11-24-1998 By: JP

This survey consists of:

Map: M 130-68

Narrative: _____

Corner Rpt: _____

DOUGLAS COUNTY SURVEYOR JP CB

LEGEND

○ SET 5/8" X 30" IRON ROD WITH YELLOW PLASTIC CAP MARKED "NYGREN LS1035".

BEARINGS BASED ON PLACER MINING CLAIM NO. 37 PER RECORD BEARING FROM CORNER NO. 12 TO THE RECORD CREEK TIE FROM CORNER NO. 6.

SURVEY NARRATIVE

THE PURPOSE IS TO MONUMENT THE CORNERS OF PLACER MINING CLAIM NO. 37 AND MARK LINES FOR LOGGING PURPOSES.

AFTER SEVERAL DAYS SEARCHING FOR RECORD CORNERS I DETERMINED THAT ALL BUT CORNER NO. 12, LOCATED AT THE NORTHWEST CORNER OF CLAIM NO. 37, WERE DESTROYED AND LOST DUE TO MINING AND LOGGING OPERATIONS WHICH HAVE OCCURED OVER THE LAST 100 YEARS. AT CORNER NO. 12 I FOUND A FIR STUMP 50 INCHES IN DIAMETER (NO VISIBLE SCRIBE) THAT COINCIDES WITH THE INITIAL POINT OF SURVEY WHICH IS LOCATED AT THE JUNCTION OF BRANDY GULCH AND HOGAM CREEK. IT ALSO AGREES WITH SOME VERY OLD LINE BLAZES AND OLD NATIONAL FOREST BOUNDARY SIGN ON OLD GROWTH TREES LOCATED 50 TO 75 FEET EAST OF CORNER NO. 12. THE TIE TO WHISKEY CREEK FROM CORNER NO. 12 IS REASONABLY CLOSE TO RECORD.

I INDEXED ON THE ORIGINAL SURVEY BY MAKING A TIE FROM CORNER NO. 12 TO THE SOUTH CREEK TIE FROM CORNER NO. 6 WHICH I COMPUTED FROM RECORD AS BEING S05°56'32"E, 3493.80 FEET FROM CORNER NO. 12. THENCE I SET CORNERS AS SHOWN ON ANNEXED MAP.

A NIKON-DTM A20LG TOTAL STATION WAS USED TO EXECUTE THIS SURVEY.

REGISTERED PROFESSIONAL LAND SURVEYOR

OREGON
GERALD V. NYGREN
AUGUST 22, 1975
1035

EXPIRES 12-31-98

COUNTY SURVEYORS FILE DATA
DO NOT REMOVE FROM OFFICE

SURVEYED FOR:		
JOHN HAYDEN 1521 QUINES CREEK ROAD AZALEA, OREGON 97410	GERALD V. NYGREN 522 BARKER DRIVE MERLIN, OREGON 97532	DATE: OCT. 25, 1998 SCALE: 1" = 200' JOB NO. 98-17

MAP FILE M130-68