# Township No. 32 South, Range No. 5 West of the Willamette Meridian, Oregon.

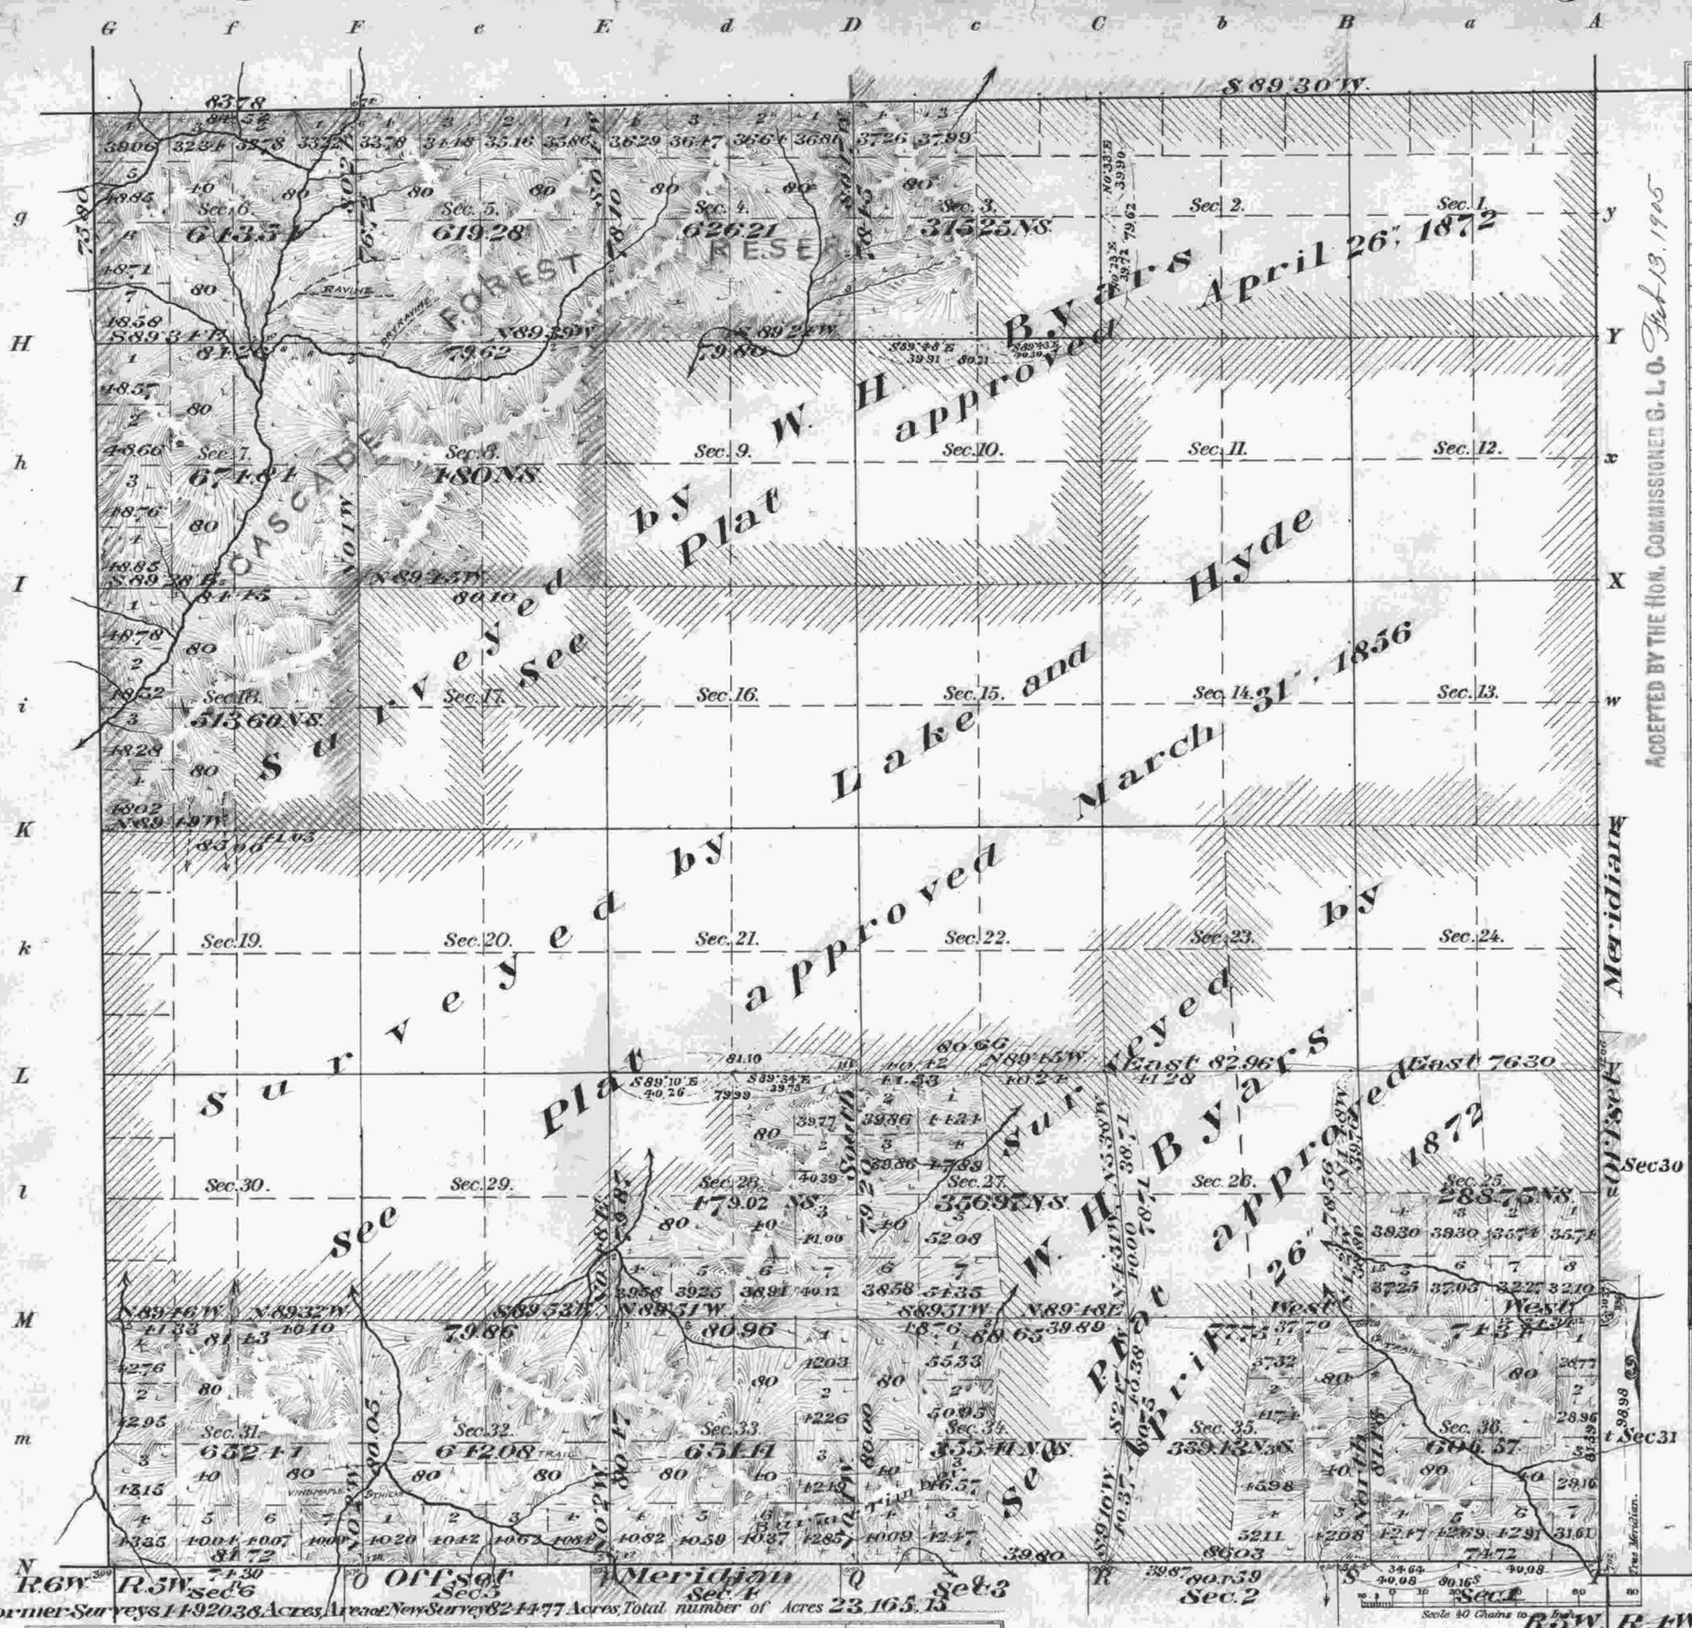


Area of Former Surveys 14920.38 Acres, Area of New Survey 8244.77 Acres, Total number of Acres 23,165.13

Latitude 42° 45' N
Longitude 123° 14' W.
Mean mag. decl. 1930 E.
} At N.W. Cor. Sec. 36

| Meanders of | | | | | | | | |
|---|---|---|---|---|---|---|---|---|
| Posts | Courses | Ch.s Lk.s | Posts | Courses | Ch.s Lk.s | Posts | Courses | Ch.s Lk.s |

| Deposited by Oregon and California R.R. Co. | | |
|---|---|---|
| For Field Work | | $300.00 |
| " Office " | | 50.00 |
| " Field Examination | | 50.00 |
| Cost of Field Work | | |
| " " " Examination | $50.00 | |
| " " Office Work | 49.00 | |
| Amount Refunded | | |

ACCEPTED BY THE HON. COMMISSIONER G. L. O. Feb. 13. 1905

| Surveys Designated | By Whom Surveyed | Date of Contract | Amount of Surveys M. | Ch.s | Lk.s | When Surveyed | No. of Contract |
|---|---|---|---|---|---|---|---|
| Township lines | | | | | | | |
| Subdivisions | Oscar F. Thiel | Dec. 24, 1900 | 14 | 46 | 56 | July 17, 27, 1901 | 729 |
| Retracements | " " " | Sept. 12, 1901 | 10 | 41 | 88 | August 19, 23, " | Special Instructions in Connection with Contract No. 729 |
| Connections | " " " | | | 11 | 59 | | |
| Retracement of Part of Bdy of Sec. 35 | " " " | " " " | 1 | 00 | 59 | " 20, " | " |
| " of Part of S. Bdies of Sec. 33 & 34 | Bd. F. Sharp | June 3, 1893 | | | | 1894 | 617 |
| North & West Bdies | Lake & Hyde | Feb. 19, 1854 | | | | 1855 | 54 |
| East & South " | Butler Ives & Hyde | Jany. 4, 1854 | | | | 1854 | 39 |
| Resurvey of S. Bdries of Secs. 3, 27, and 36; E. Bdy of Sec. 3. | O. F. Thiel | Dec. 24, 1900; April 30, 1904 | 3 | 74 | 54 | July 13 to 18, 1904 | Special Instructions in Connection with Contract No. 729 |

J.N.D.

J.W. (amendment)

The above Map of Township No. 32 South, of Range No. 5 West, of the Willamette Meridian, Oregon, is strictly conformable to the field notes of the survey thereof on file in this Office, which have been examined and approved.

Surveyor General's Office,
Portland, Oregon, July 17, 1902.

Kenny Mulkey
Sur. Gen'l for Oregon.

The above Map of Township No. 32 South, of Range No. 5 West, of the Will. Mer. Oregon, has been amended to conform to the field notes of the resurvey and retracement made by O. F. Thiel, D.S. on file in this Office, which have been examined and approved, made by order of Hon. Commissioner's Letters "E" dated April 30, 1904 and May 31, 1904.

Surveyor General's Office
Portland, Oregon, Dec. 16, 1904.

Geo. D. Daly
Sur. Gen'l for Oregon