TOWNSHIP 32 SOUTH, RANGE 6 WEST, OF THE WILLAMETTE MERIDIAN, OREGON

CORRECTIVE DEPENDENT RESURVEY, CORRECTIVE SURVEY AND DEPENDENT RESURVEY

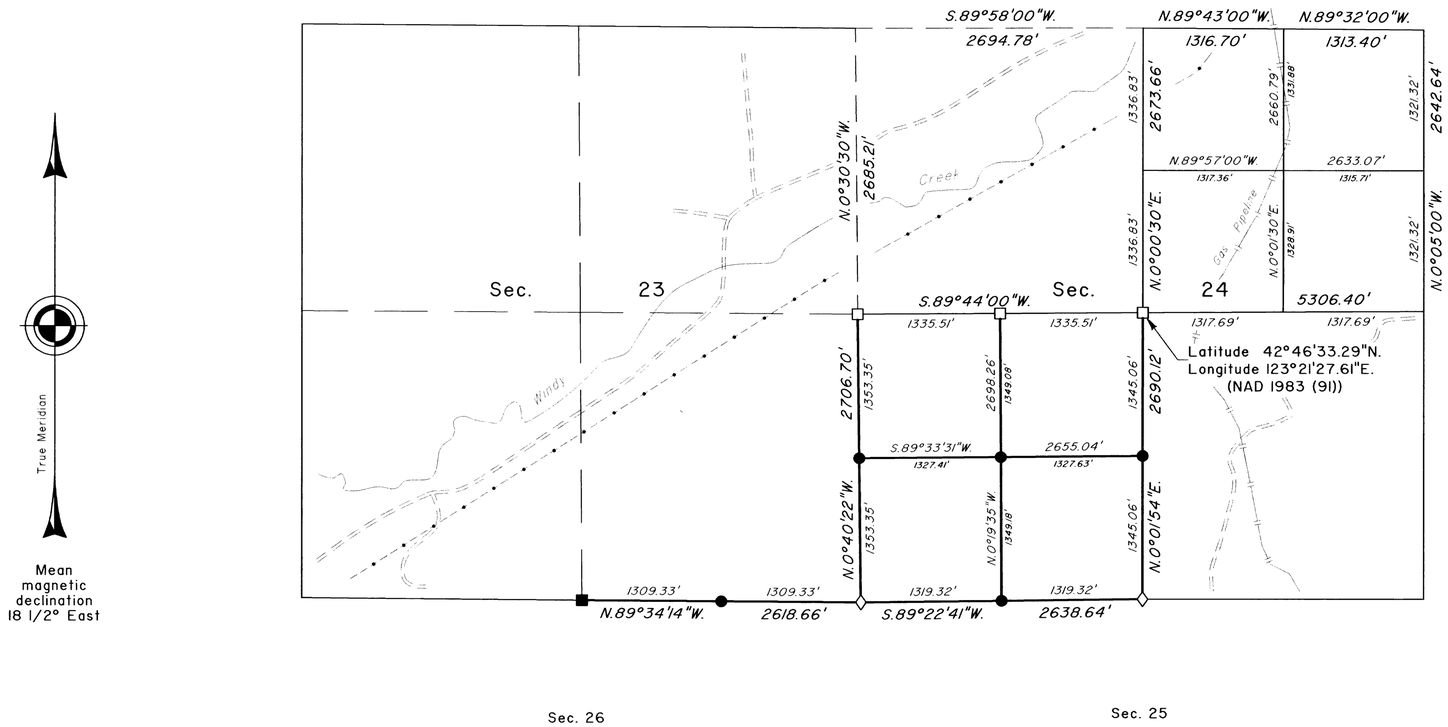

A history of surveys is contained in the field notes.

This plat represents a corrective dependent resurvey of a portion of the subdivisional lines, corrective survey of a portion of the subdivision of section lines of section 24, and dependent resurvey of a portion of the subdivisional lines, T. 32 S., R. 6 W., Willamette Meridian, Oregon, designed to restore the corners in their true original locations according to the best available evidence.

Measured distances and directions have been adjusted by Cadastral Measurement Management (CMM), computer software that incorporates a least squares adjustment routine. The adjusted bearings and distances are reported to the nearest second and 0.01 foot.

The lottings and areas are as shown on the plat approved May 31, 1882.

The survey was executed by Randall M. Zanon, Cadastral Surveyor, beginning September 19, 2001, and completed November 8, 2001, pursuant to Special Instructions dated September 21, 2000, under Group Number 1966, Oregon.

Timber in this area consists of fir, pine, cedar, madrone, oak, maple, chinquapin, and alder.

The light weight lines were resurveyed or surveyed by Francis J. Simon, in 1992.

LEGEND

- ◇ Original corner previously remonumented
- □ Corner previously established or reestablished
- ■ Corner previously established or reestablished; remonumented this survey
- ● Corner established or reestablished this survey

UNITED STATES DEPARTMENT OF THE INTERIOR
BUREAU OF LAND MANAGEMENT

Portland, Oregon July 18, 2003

This plat is strictly conformable to the approved field notes, and the survey, having been correctly executed in accordance with the requirements of law and the regulations of this Bureau, is hereby accepted.

For the Director

Mary J. M. Hautel

Chief Cadastral Surveyor of Oregon

1000 500 0 1000 2000 3000 4000 5000 6000

Scale in Feet

D.C.W.