FILED
Date 4/16/2008 By: JC
This survey consists of:
Map
Narrative NO LINENOTES
Camp Rpt.
DOUGLAS COUNTY SURVEYOR

TOWNSHIP 32 SOUTH, RANGE 6 WEST, OF THE WILLAMETTE MERIDIAN, OREGON

RETRACEMENT

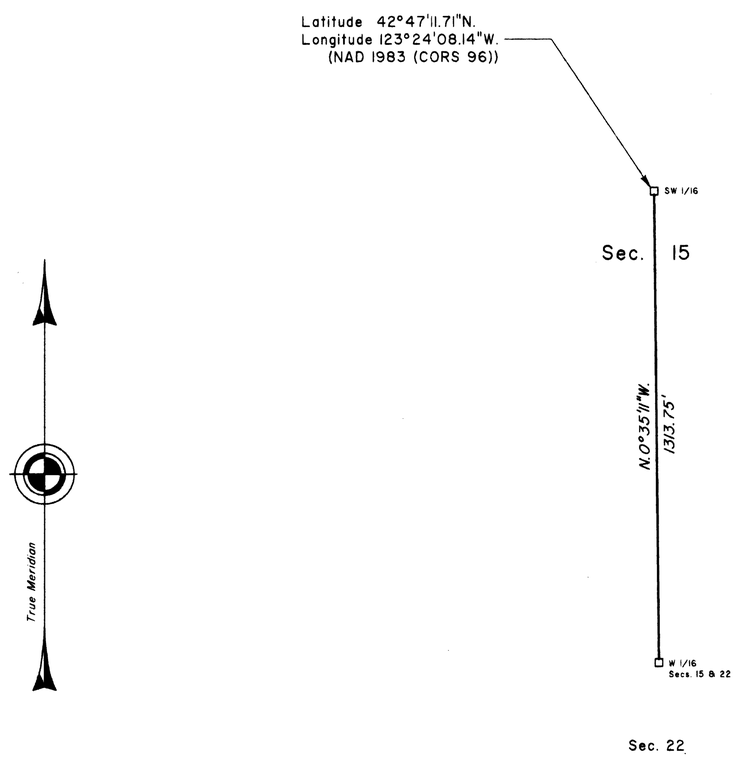

I, Arthur R. Rambo, Cadastral Surveyor, HEREBY CERTIFY upon honor, that in pursuance of special instructions bearing date of the 8th day of March, 2004, and the 16th day of March, 2007, I have retraced a portion of the subdivision-of-section lines of section 15, Township 32 South, Range 6 West, of the Willamette Meridian, in the State of Oregon, which is represented upon this plat as having been executed by me and under my direction. Said survey has been made in strict conformity with said special instructions, the Manual of Instructions for the Survey of the Public Lands of the United States, and in specific manner described upon this plat.

Arthur R. Rambo — Cadastral Surveyor

February 17, 2008 — Date

300 200 100 0 300 600 900 1200 1500 1800 2100 2400

Scale in Feet

This plat represents the entire survey record of the retracement of a portion of the subdivision-of-section lines of section 15, T. 32 S., R. 6 W., Willamette Meridian, Oregon.

The history of surveys pertaining to this retracement is as follows:

In 1881, William H. Byars, U.S. Deputy Surveyor, surveyed a portion of the subdivisional lines.

In 1966-67, Rollin D. Aanrud, Cadastral Surveyor, resurveyed a portion of the subdivisional lines, and subdivided sec. 15.

In 1976, Lynn M. Roseberry and Rollin D. Aanrud, Cadastral Surveyors, resurveyed a portion of the subdivisional lines.

In 1986-89, Mark D. Dixon and Henry E. Hartley, Cadastral Surveyors, correctively resurveyed a portion of the subdivisional lines, correctively surveyed a portion of the subdivision-of-section lines of section 15, resurveyed a portion of the subdivision-of-section lines of section 15, and subdivided sections 3, 10, 14, and 15.

This retracement was executed by Arthur R. Rambo, Cadastral Surveyor, beginning July 11, 2006, and completed December 6, 2006, pursuant to Special Instructions dated March 8, 2004, under Group 2100, Oregon, and Special Instructions dated March 16, 2007, under Group 2300, Oregon, and Group 2100, Oregon, reassignment dated October 10, 2007, and Assignment Instructions dated July 10, 2006. He was assisted by Judi L. Becker and Logan B. McConnell, Survey Technicians.

The directions of the lines are based on the true meridian as determined by global positioning system observations.

An analysis of the unadjusted field data assured a closure not exceeding 1:4000 in error. Measured distances and directions have been adjusted by computer software that incorporates a least squares adjustment routine. The adjusted bearings and distances are reported to the nearest second and 0.01 foot.

The geographic position in (NAD 1983 (CORS96)) shown hereon, was determined by a tie to a temporary point, established utilizing NAVSTAR Global Positioning System static data, with NSRS CORS stations "CAPE BLANCO" and "DODSON BUTTE".

LEGEND

□ Corner previously established or reported in 1986-89

UNITED STATES DEPARTMENT OF THE INTERIOR
BUREAU OF LAND MANAGEMENT

Portland, Oregon

The retracement represented by this plat, having been correctly executed in accordance with the requirements of law and the regulations of this Bureau, is hereby accepted.

For the Director

Mary J. M. Hartel

Chief Cadastral Surveyor of Oregon

February 29, 2008

Date

R.L.L.

Per note from BLM at the time of notification of final plat, there are no field notes.