998

Township No. 32 South Range No. 7 West of the Willamette Meridian, Oregon.

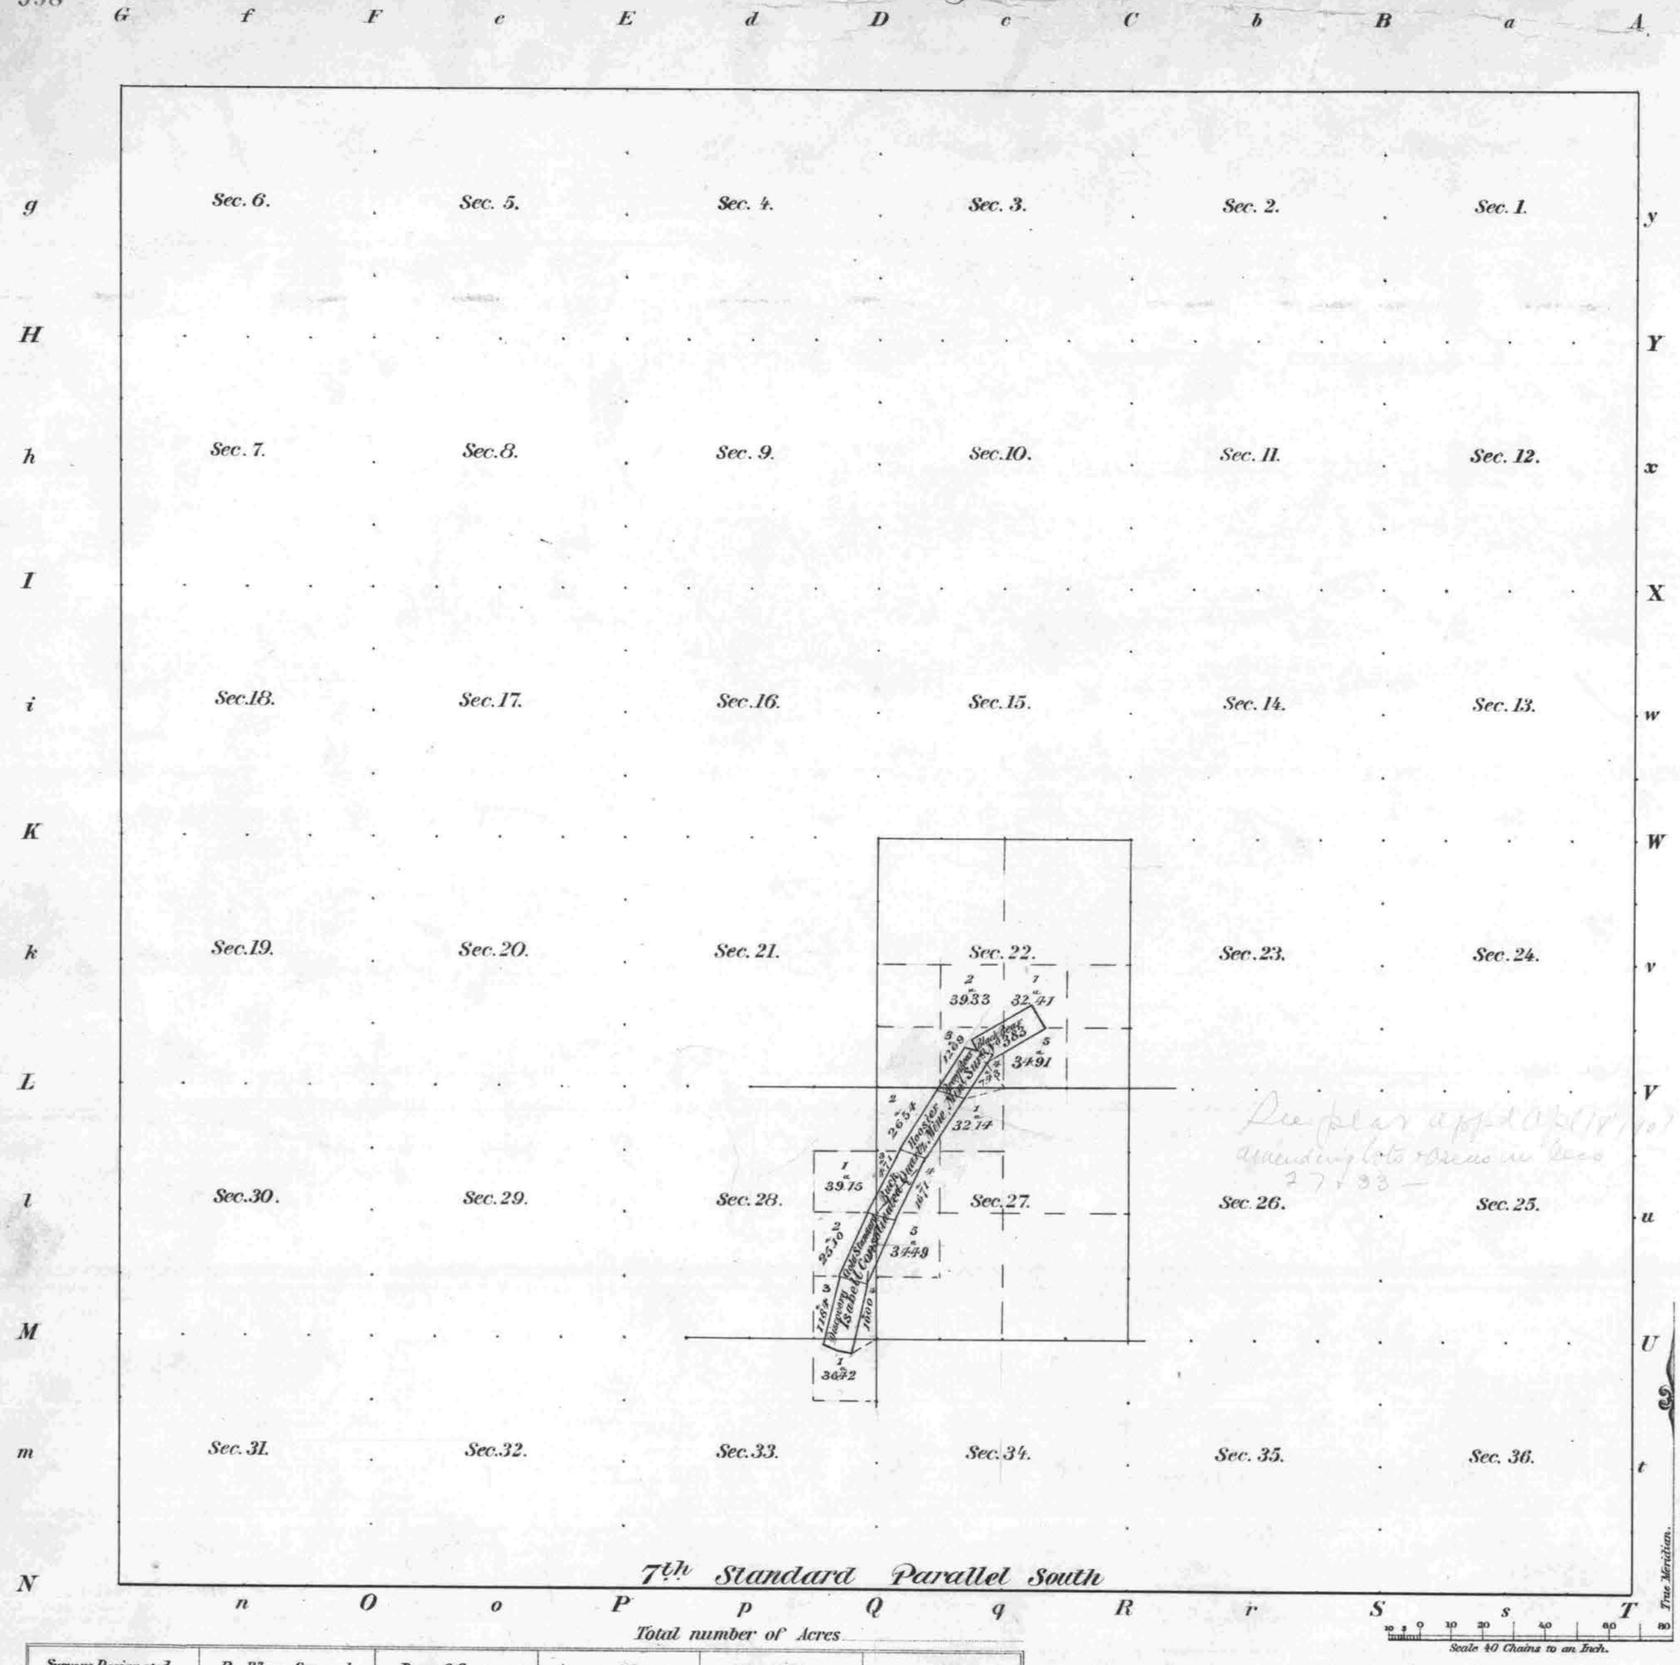

See plat app'd Oct 18, 1900 amending lots & areas in Secs 27 & 33

Meanders of								
Posts	Courses	Ch.s Lk.s	Posts	Courses	Ch.s Lk.s	Posts	Courses	Ch.s Lk.s

The above Plat showing changes in areas and lottings in Secs. 22, 27, 28 & 33 Tp. No. 32 S. Range 7 W. W. M. Oregon, consequent upon platting M.S. No. 3831 is correct and hereby approved.
U.S. Surveyor Generals Office
Portland, Oregon.
March 27, 1906.

Robert A. Habersham
U.S. Surveyor Gen'l for Oregon.

Total number of Acres

Surveys Designated	By Whom Surveyed	Date of Contract	Amount of Surveys M. Ch.s Lk.s	When Surveyed	
Township lines					
Subdivisions					

The above Map of Township No. ..... of Range No. ..... Meridian, is strictly conformable to the field notes of the survey thereof on file in this Office, which have been examined and approved.

Surveyor Generals Office. } ..... Sur.r Gen.l