TOWNSHIP 32 SOUTH, RANGE 7 WEST, OF THE WILLAMETTE MERIDIAN, OREGON

DEPENDENT RESURVEY

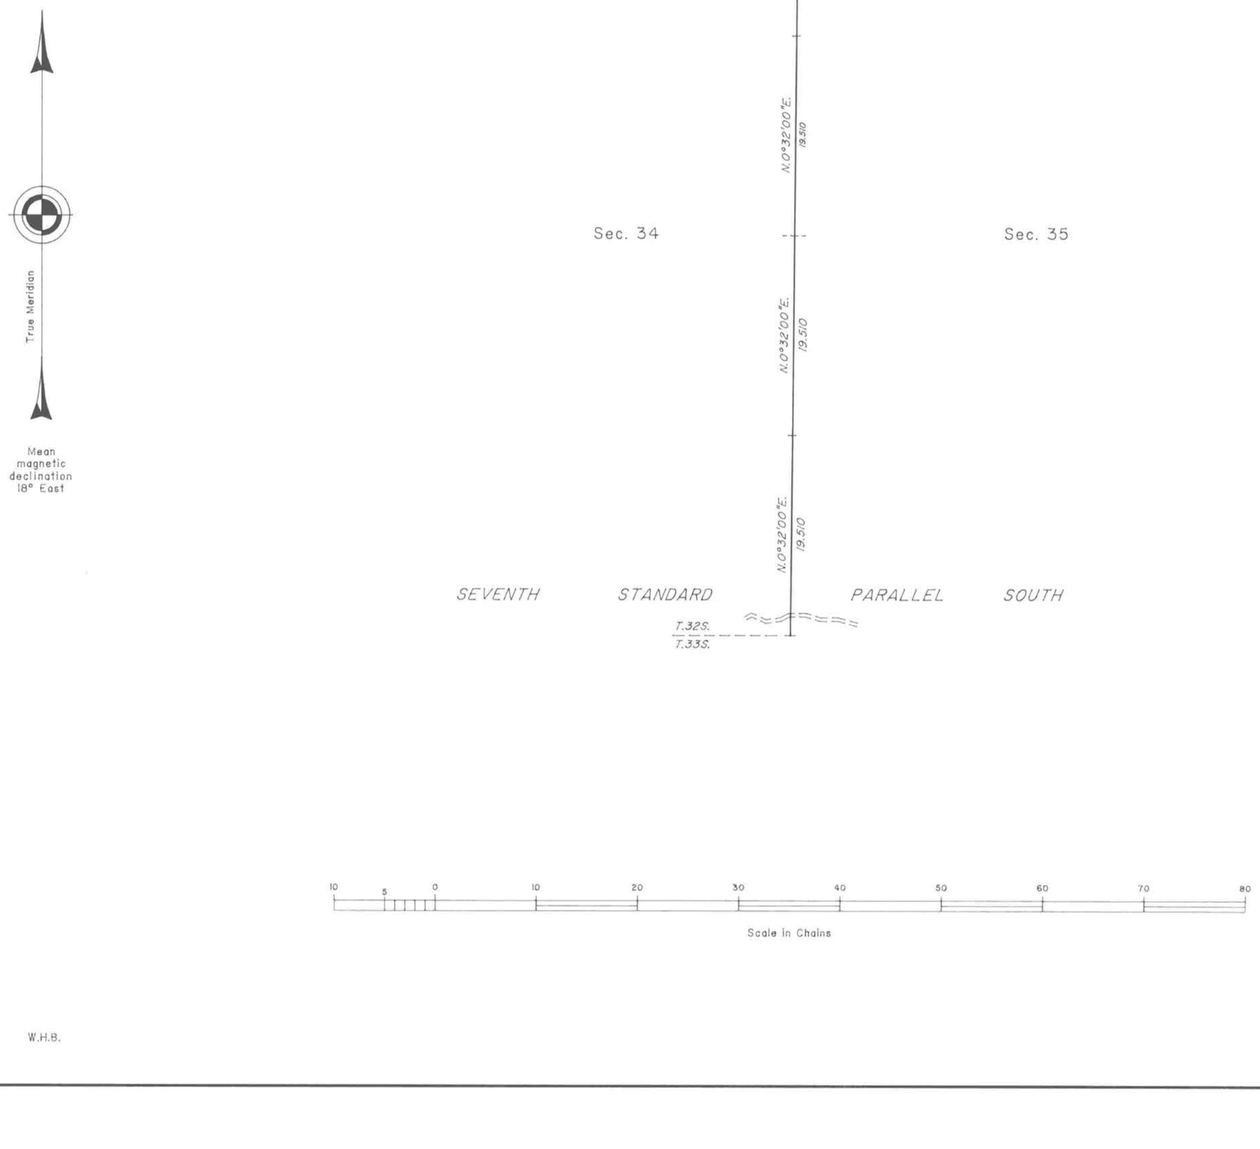

A history of surveys is contained in the field notes.

This plat represents a dependent resurvey of the line between sections 34 and 35, T. 32 S., R. 7 W., Willamette Meridian, Oregon.

The survey was executed by Terrence O. Nickerson, Cadastral Surveyor, and Gordon L. Caster, Surveying Technician, beginning March 26, 1990, and completed April 2, 1990, pursuant to Special Instructions dated March 14, 1990, under Group Number 1528, Oregon.

Timber in this area consists of fir, pine, cedar, madrone, oak and chinquapin.

UNITED STATES DEPARTMENT OF THE INTERIOR
BUREAU OF LAND MANAGEMENT

Portland, Oregon April 28, 1993

This plat is strictly conformable to the approved field notes, and the survey, having been correctly executed in accordance with the requirements of law and the regulations of this Bureau, is hereby accepted.

For the Director

Wayne M. Gardner

Chief Cadastral Surveyor of Oregon

W.H.B.