TOWNSHIP 32 SOUTH, RANGE 7 WEST, OF THE WILLAMETTE MERIDIAN, OREGON

DEPENDENT RESURVEY AND SUBDIVISION OF SECTIONS 20 AND 35

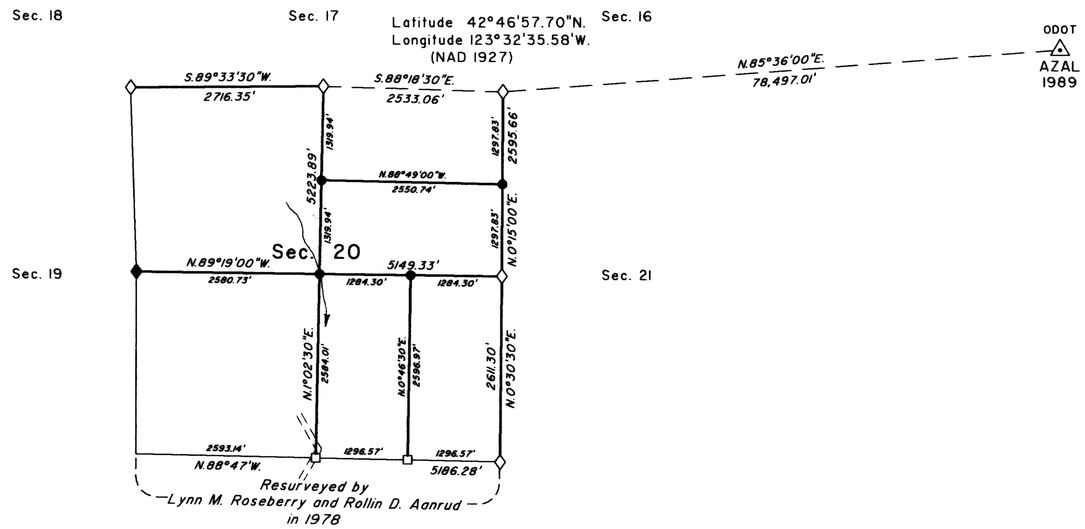

A history of surveys is contained in the field notes.

This plat represents a dependent resurvey of a portion of the subdivisional lines, T. 32 S., R. 7 W., Willamette Meridian, Oregon, designed to restore the corners in their true original locations according to the best available evidence, and the subdivision of sections 20 and 35.

Except as shown hereon, the lottings and areas are as shown on the plat approved May 31, 1882.

The survey was executed by Stephan L. Barott, Cadastral Surveyor (Forest Service, U.S. Department of Agriculture), beginning April 17, 2002, and completed November 9, 2002, pursuant to Special Instructions dated August 6, 2001, under Group Number 1995, Oregon.

Timber in this area consists of fir, pine, cedar, oak, and madrone.

The ties to the geodetic control stations are reported as mean bearing and sea level distance.

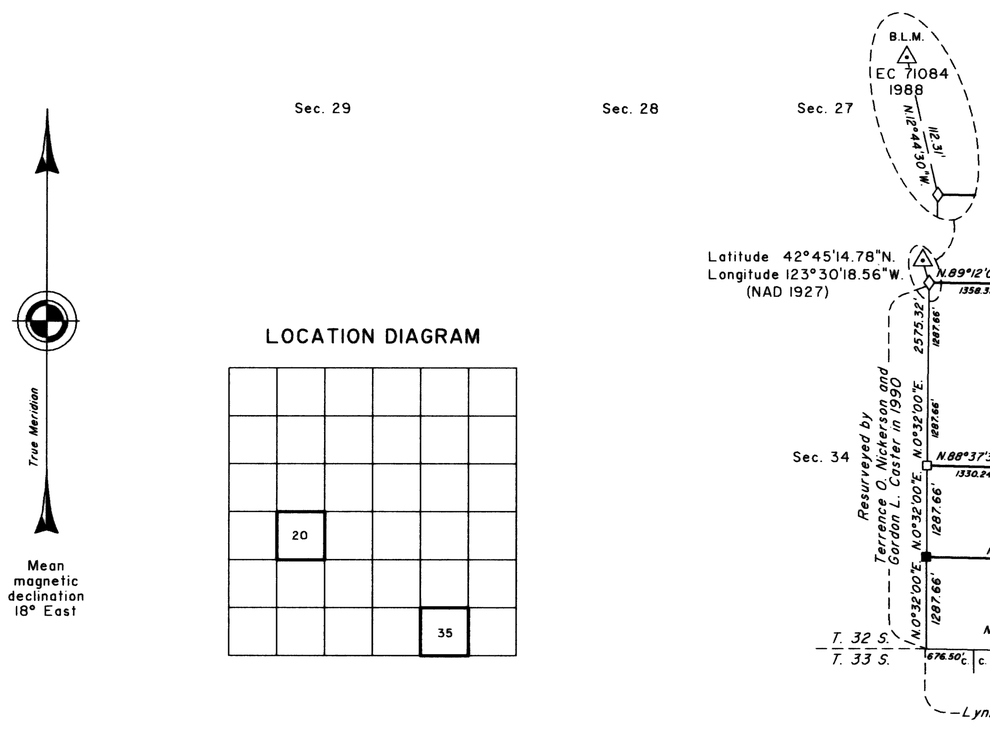

LEGEND

- ◇ Original corner previously remonumented
- ◆ Original corner remonumented this survey
- □ Corner previously established or reestablished
- ■ Corner previously established or reestablished; remonumented this survey
- ● Corner established or reestablished this survey

UNITED STATES DEPARTMENT OF THE INTERIOR
BUREAU OF LAND MANAGEMENT

Portland, Oregon November 15, 2004

This plat is strictly conformable to the approved field notes, and the survey, having been correctly executed in accordance with the requirements of law and the regulations of this Bureau, is hereby accepted.

For the Director

Mary J. M. Hartill

Chief Cadastral Surveyor of Oregon