TOWNSHIP 33 SOUTH, RANGE 5 WEST, OF THE WILLAMETTE MERIDIAN, OREGON.

DEPENDENT RESURVEY, SUBDIVISION OF SECTION 21, AND REMONUMENTATION

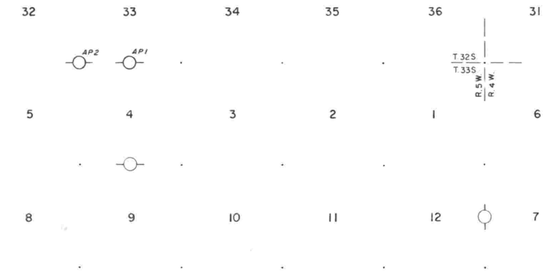

REMONUMENTATION DIAGRAM

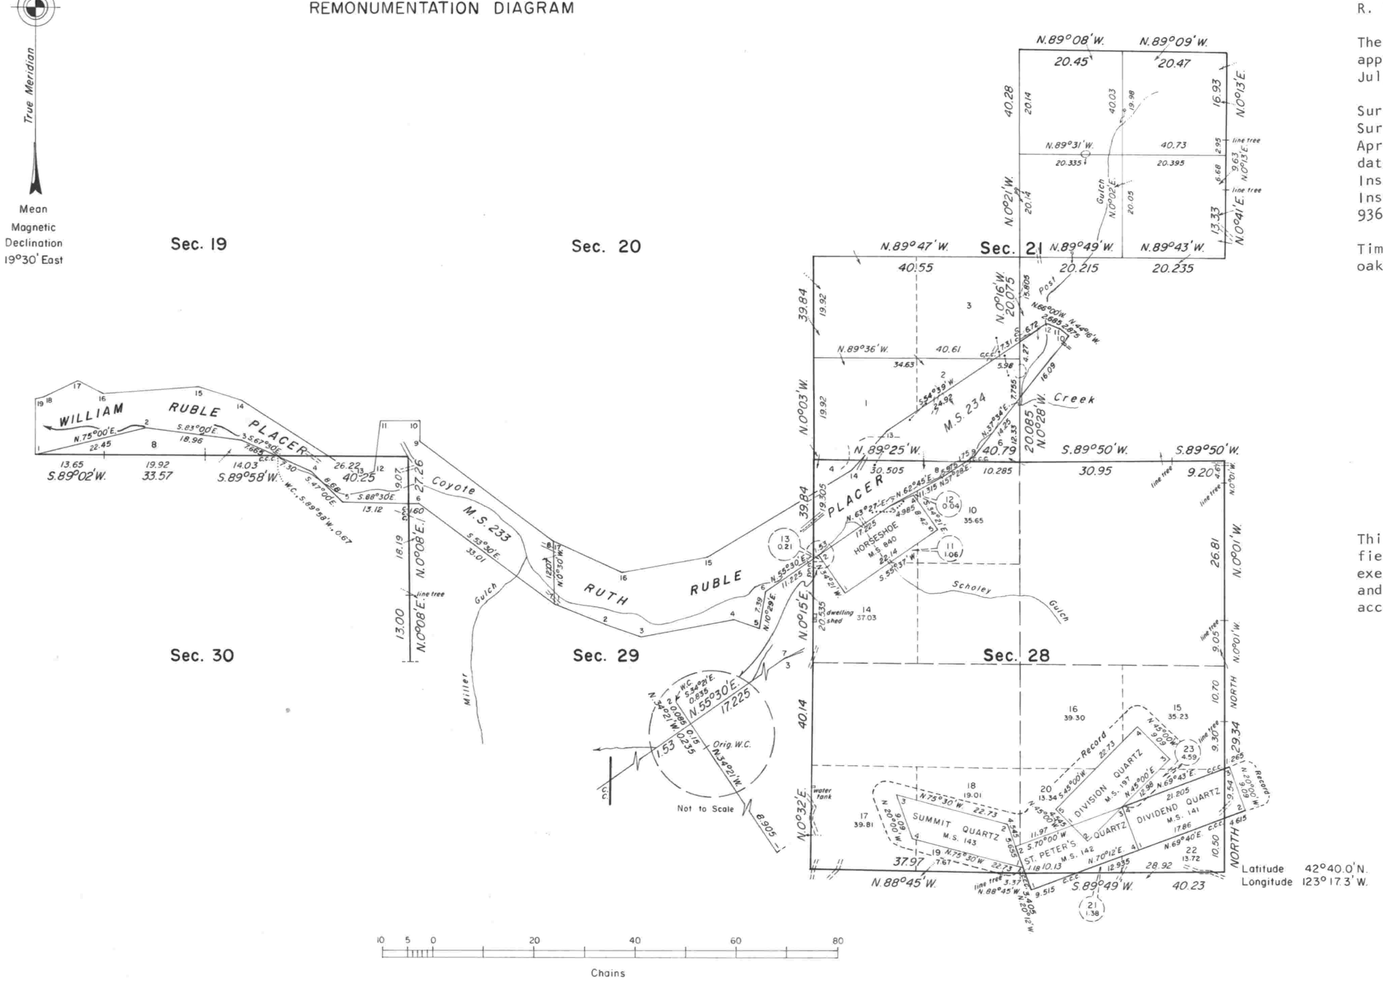

A history of surveys is contained in the field notes.

This plat represents a dependent resurvey of a portion of the subdivisional lines and claim lines, subdivision of section 21, and remonumentation of certain original corner points, designed to restore the corners in their true original locations according to the best available evidence, T. 33 S., R. 5 W., Willamette Meridian, Oregon.

The lottings and areas are as shown on the plats approved November 10, 1891, November 16, 1894, and July 27, 1898, and approved mineral survey records.

Survey executed by Lynn M. Roseberry, Cadastral Surveyor, beginning July 18, 1977, and completed April 11, 1980, pursuant to Special Instructions dated June 21, 1977, Amendment to Special Instructions, dated October 4, 1977, and Special Instructions dated July 13, 1979, for Group Nos. 936 and 1000, Oregon.

Timber in this area consists of fir, pine, cedar, oak, and madrone.

UNITED STATES DEPARTMENT OF THE INTERIOR
BUREAU OF LAND MANAGEMENT
Portland, Oregon November 10, 1982

This plat is strictly conformable to the approved field notes, and the survey, having been correctly executed in accordance with the requirements of law and the regulations of this Bureau, is hereby accepted.

For the Director

William W. Glenn

Chief Cadastral Surveyor of Oregon

R.T.S.