


Total number of Acres 16,371.77

SURVEYS DESIGNATED.	BY WHOM SURVEYED.	NO.	DATE OF CONTRACT.	AMOUNT OF SURVEYS.			WHEN SURVEYED.	MEAN DECLINATION.
				Miles.	Chains.	Links.		
Township Lines	W.H. Byars	420	Sept. 16, 1881	8	00	00	Feb. 6 to March 23 1882	18° E
Subdivisions	do. do. do.			45	13	41		
Corrections	do. do. do.				30	53		

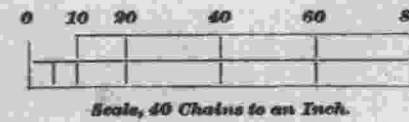

ACCEPTED BY THE HON. COMMISSIONER G. L. D. *James* 14. 1882

The above map of the subdivisions of Township No. 33 South of Range No. 7 West of the Willamette Meridian, Oregon, is strictly conformable to the Field Notes of the survey thereof on file in this office, which have been examined and approved.

U. S. Surveyor-General's Office,
Portland, Oregon,

May 31, 1882. *James C. Tolman*
Surveyor-General of Oregon.