ORIGINAL

TOWNSHIP 33 SOUTH, RANGE 7 WEST, OF THE WILLAMETTE MERIDIAN, OREGON.

DEPENDENT RESURVEY, REMONUMENTATION, AND SUBDIVISION OF SECTION 1

R. 7 W. T. 32 S. R. 6 W.

Sec. 35 Sec. 36 Sec. 31

SEVENTH STANDARD PARALLEL SOUTH

Sec. 2

Sec. 11 Sec. 12

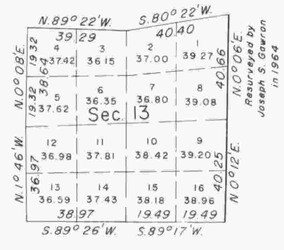

Sec. 14

Sec. 21 Sec. 22 Sec. 23 Sec. 24

Sec. 30 Sec. 29 Sec. 28 Sec. 27 Sec. 26 Sec. 25

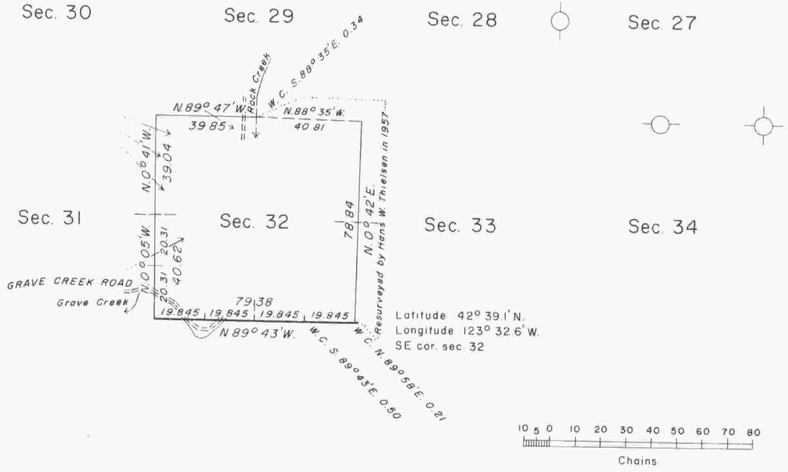

10 5 0 10 20 30 40 50 60 70 80
Chains

Area resurveyed: 1267.58 acres

Mean magnetic declination

19° 12' E.

Timber in this area consists of fir, pine, cedar, madrone, oak, maple, alder, and chinquapin.

SGW-4/71

This plat represents a dependent resurvey of a portion of the Seventh Standard Parallel South; a portion of the south and east boundaries and subdivisional lines, and the remonumentation of certain original corner points in Township 33 South, Range 7 West, Willamette Meridian, Oregon, designed to restore the corners in their true original location according to the best available evidence; and, the subdivision of Section 1.

Except as indicated the lottings and areas are as shown on the plat approved May 31, 1882.

The east boundary of the township was surveyed by Wells Lake and George W. Hyde, in 1855.

The Seventh Standard Parallel South, north boundary of the township, was surveyed by William H. Byars, in 1881.

In 1882, William H. Byars surveyed the south boundary and the subdivisional lines, except for the northwest portion of the township.

Hans W. Thielsen resurveyed a portion of the subdivisional lines in 1957.

The north two and one-half miles of the east boundary were resurveyed, and the corner of sections 13, 18, 19, and 24, on the east boundary of the township, was remonumented without survey by Joseph S. Gawron, in 1963-64.

The resurvey, subdivision of section 1 and remonumentation were executed by John M. Jelley, Rollin D. Aanrud, and Lynn M. Roseberry, Cadastral Surveyors, from May 15, 1969 to March 11, 1970, under Special Instructions dated May 3, 1957 and May 13, 1969, which provide for the surveys included under Group Nos. 350 and 688, Oregon.

✧ Remonumentation under Group No. 350 in 1969.

UNITED STATES DEPARTMENT OF THE INTERIOR
BUREAU OF LAND MANAGEMENT
Washington, D.C. March 15, 1972

This plat is strictly conformable to the approved field notes, and the survey, having been correctly executed in accordance with the requirements of law and the regulations of this Bureau, is hereby accepted.

For the Director

Clark L. Lumm

Chief, Division of Cadastral Survey